# Seismic Retrofitting Project: Assessment of Prototype Buildings

Volume 2

# **Research Report**

Claudia Cancino, Sara Lardinois, Dina D'Ayala, Carina Fonseca Ferreira, Daniel Torrealva Dávila, Erika Vicente Meléndez, and Luis Villacorta Santamato

Los Angeles 2012



# Seismic Retrofitting Project: Assessment of Prototype Buildings Volume 2

By Claudia Cancino, Sara Lardinois, Dina D'Ayala, Carina Fonseca Ferreira, Daniel Torrealva Dávila, Erika Vicente Meléndez, and Luis Villacorta Santamato

Los Angeles 2012

THE GETTY CONSERVATION INSTITUTE LOS ANGELES

 $\ensuremath{\mathbb{C}}$  2013 J. Paul Getty Trust

The Getty Conservation Institute 1200 Getty Center Drive, Suite 700 Los Angeles, CA 90049-1684 United States Telephone 310 440-7325 Fax 310 440-7702 E-mail gciweb@getty.edu www.getty.edu/conservation

The Getty Conservation Institute works to advance conservation practice in the visual arts, broadly interpreted to include objects, collections, architecture, and sites. It serves the conservation community through scientific research, education and training, model field projects, and the broad dissemination of the results of both its own work and the work of others in the field. And in all its endeavors, it focuses on the creation and dissemination of knowledge that will benefit professionals and organizations responsible for the conservation of the world's cultural heritage.

# Contents

Volume 1	
Project Participants	v
CHAPTER 1	
Background	
1.1 Introduction	1
1.2 Institutional Background and Project Partners	1
1.3 Seismic Retrofitting Project	2
1.4 Introduction to Assessment Report	5
CHAPTER 2	
Methodology	
2.1 Previous Assessments	7
2.2 Selection of Prototype Buildings	8
2.3 Assessment Methodology	12
CHAPTER 3	
Hotel El Comercio	
3.1 Summary	29
3.2 Historical Background, Context, and Significance	30
3.3 Architectural Description	33
3.4 Geological and Environmental Description	38
3.5 Structural Description	38
3.6 Irregularities, Alterations, Damages, and Decay	49
3.7 Preliminary Findings	53
CHAPTER 4	
Cathedral of Ica	
4.1 Summary	55
4.2 Historical Background, Context, and Significance	56
4.3 Architectural Description	59
4.4 Geological and Environmental Description	63
4.5 Structural Description	64

4.6 Irregularities, Alterations, Damages, and Decay	78
4.7 Preliminary Findings	86
CHAPTER 5	
Church of Kuño Tambo	
5.1 Summary	89
5.2 Historical Background, Context, and Significance	90
5.3 Architectural Description	92
5.4 Geological and Environmental Description	96
5.5 Structural Description	96
5.6 Irregularities, Alterations, Damages, and Decay	106
5.7 Preliminary Findings	111
CHAPTER 6	
Casa Arones	
6.1 Summary	115
6.2 Historical Background, Context, and Significance	116
6.3 Architectural Description	121
6.4 Geological and Environmental Description	125
6.5 Structural Description	125
6.6 Irregularities, Alterations, Damages, and Decay	137
6.7 Preliminary Findings	142
CHAPTER 7	
Conclusions	
7.1 Conclusions After the Assessment	147
Bibliography	153
Glossary of Architectural Terms	157
y <del>-</del>	
Volume 2	
Appendix A: Survey Form Example	
Appendix B: Architectural Drawings	
Appendix C: Prospection Drawings	

# **APPENDIX A**

# Survey Form Example









Building: Cat	hedral of Ica	Antigua Catedral de Ica
Original constru Date of survey:	Cajamarca (Libertad) esquina con Call ction date: Period: / / / DSL / DCC / DLV / DDT / DEV / [	
General data		
will require you  Casona: Adobe Adobe Church: Adobe roofin	the primary material only. Later sections describing additional materials.  e one story e two stories e and quincha, two or more stories  e walls, quincha vault/dome g system e walls, wooden truss roofing	Context:  Within: Historic district/center Curban environment Country side Adjacent to other buildings (wall to wall): i. If yes, indicated in the floor plan ii. Define building location within the block: End of the block Corner Middle Close to other buildings: Distance:
<b>Setting:</b> □ Flat □ Slope	Occupancy:  Unoccupied Occupied: # @ day: # @ night:	Shape in plan:  Rectangular Square "C" "L"  Other/Mixed
<b>X-direction</b> ; < 0.5% □ 0	for whole building = wall volume in  Corresponding street:	12.0-2.5% 🗆 2.5-3.0%% 🗆 3.0-3.5% 🗆 3.5-5.0% 🗆 5.0%
		□2.0-2.5% □ 2.5-3.0%% □3.0-3.5% □ 3.5-5.0% □ 5.0%
☐ 1st i ☐ On ☐ Sev # of H # of ro # of b ☐ Comm ☐ Musei ☐ Religio	<del></del>	Social-economic characteristics:  Economic level of inhabitants:  Very poor Poor Middle class Wealthy NA  Ownership: Rent: Short term Long term Own by institution: State  Church
☐ Other	:	☐ Community ☐ Own by individual









	eral description:
Hist	tory of alterations: Please listed attached documents to the current survey for:
	1.
	2.
	3
	4.
	F
	5
Soil	configuration/type:
Soil	
Soil	configuration/type:
f da	configuration/type:ata is provided of soil analysis and identification, indicate as reference:
f da	configuration/type:ata is provided of soil analysis and identification, indicate as reference:
f da	configuration/type:ata is provided of soil analysis and identification, indicate as reference:
f da Ma	configuration/type:  ata is provided of soil analysis and identification, indicate as reference:  aintenance:  Existence of maintenance plan, if yes, by who and how regular:
f da Ma	configuration/type:  ata is provided of soil analysis and identification, indicate as reference:  aintenance:  Existence of maintenance plan, if yes, by who and how regular:  Reports of previous earthquake damage:  Yes
f da Ma	configuration/type:  ata is provided of soil analysis and identification, indicate as reference:  aintenance:  Existence of maintenance plan, if yes, by who and how regular:  Reports of previous earthquake damage:
f da Ma	configuration/type:  ata is provided of soil analysis and identification, indicate as reference:  aintenance:  Existence of maintenance plan, if yes, by who and how regular:  Reports of previous earthquake damage:  Yes
f da Ma	configuration/type:  ata is provided of soil analysis and identification, indicate as reference:  aintenance:  Existence of maintenance plan, if yes, by who and how regular:  Reports of previous earthquake damage:  Yes










The Getty Conservation Institute

# Quality of original workmanship:

Base on vi	sual inspection, the quality of original workmanship in the following elements is considered:
□ Y	e arches or roof structure properly constructed? Yes No, describe:
□ N Ceiling:	NA / Non existent
Where the	e beams and joists properly constructed? Yes No, describe:
Masonry: Where the	NA / Non existent  e fabric of the original masonry walls (adobe, quincha, tapial, etc.) properly laid out?  Yes (when the staggering in half the length of the adobe)  No, describe:
Foundation Where the	NA / Non existent  Dons:  e fabric of the foundations ( <i>Cimentación, Sobrecimiento</i> ) properly laid out?  Yes (when the stone are regular and regularly staggered)  No, describe:
	NA / Non existent lage and/or footprint:

# Sa



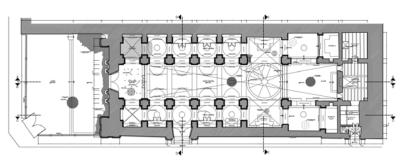

## Earthen Architecture Initiative

## Structural Assessment Survey Form - Seismic Retrofitting Project (SRP)










The Getty Conservation Institute

#### **Sectors:**

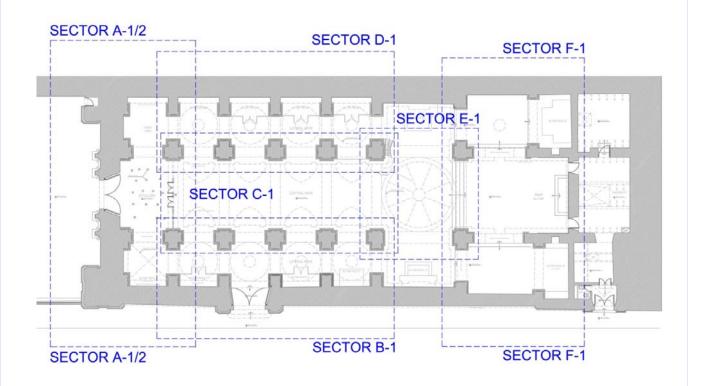

### Criteria for sectors selection:

The survey team pre-divided the building in 6 different sectors, 6 sectors (A, B, C, D, E & F) on the first floor and 1 sector (A-2) over the "Sotocoro", plus the final roof. The sectors were divided according to the following criteria:

1. Potential structural behavior during an earthquake.

- Structural and architectural composition.
   Construction materials and techniques.
- Time of construction.
- Additions and/or interventions.











The Getty Conservation Institute

Building: Cathedral of Ica	Antigua Catedral
Address:	
Sector:	
Sector type :	TO THE
☐ Courtyard / ☐ Tower / ☐ Group of rooms / ☐ Individual Room / ☐ Roof	a di i
Level: ☐ First floor / ☐ Second floor / ☐ Third floor	

## I. Location of sector in building:

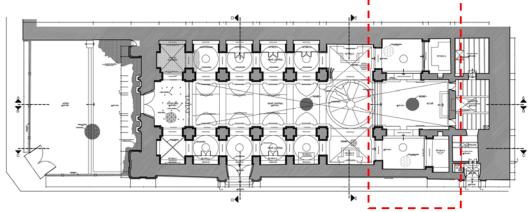

# II. Floor plan of sector:

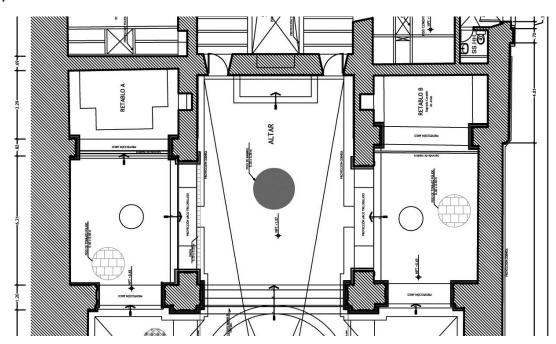









III.Sector cross sections, elevations or photos:	









IV.General seismic performance and vulnerability	
Shape of the building sector:  Rectangular, Square, "C", "L", Other/Mixed	Average span between walls:  X-Direction:  Y-Direction:
Wall density: Wall density per sector = wall area in the x or y-direc	tion/total area of the sector
X-direction	Y-direction
Corresponding street:	Corresponding street:
□ < 0.5% □ 0.5-1.0% □ 1.0-1.5% □ 1.5-2.0% □ 2.0-2.5% □ 2.5-3.0% □ 3.0-3.5% □ 3.5-5.0% □ >5.0%	□ < 0.5% □ 0.5-1.0% □ 1.0-1.5% □ 1.5-2.0% □ 2.0-2.5% □ 2.5-3.0% □ 3.0-3.5% □ 3.5-5.0% □ >5.0%
Vertical load-bearing walls seem to be attached to the foundation (first floor only):  ☐ Yes ☐ No ☐ NA	Vertical load-bearing walls seem to be attached to the floors/roof structures (others and last floor):  ☐ Yes ☐ No ☐ NA
1. Maintenance:  a. General condition of building sector materials is outlined and the sector materials is outlined and the sector building sector materials is outlined and the sector building sector materials is outlined and the sector building sector materials is outlined and sector building sector buildin	










The Getty Conservation Institute

# V. Indicate location of photographs of conditions taken (Section VII):

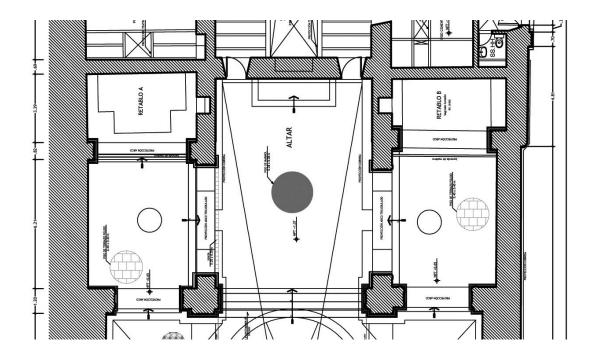



Cathedral of Ica - SECTOR #







The Getty Conservation Institute

By:  $\Box$ AF /  $\Box$ SL /  $\Box$ CC /  $\Box$ LV /  $\Box$ DT /  $\Box$ EV /  $\Box$ DDA /  $\Box$ VN/  $\Box$ CF

#### VI. Description of structural system sector: Type **Foundations** Cimentación Sub-type **Details** % of sub-type per sector Condition ☐ Mark here if ☐ Cohesive system is ■ Non-cohesive Solid Rock assumed only □ <25% □ 25-50% □ Natural Stiff soil 2000 2000 □ 50-75% □ 75-100% □100% ☐ Structure rock ☐ Mark here if ☐ Cohesive system is ■ Non-cohesive assumed only ☐ Rubble stone □ <25% □ 25-50% High: □ 50-75% □ 75-100% □100% 0000 ☐ Mad made: Stone "*cimentación"* with ☐ Cohesive mud/lime mortar ■ Non-cohesive ☐ Stone masonry □ <25% □ 25-50% High: □ 50-75% □ 75-100% □100% 000 CB Sobrecimiento **Details** % of sub-type per facade Condition Sub-type ☐ Cohesive ■ Non-cohesive ☐ Mark here if ☐ Rubble stone □ <25% □ 25-50% system is □ 50-75% □ 75-100% □100% High: assumed only 8700D "Sobrecimiento" with mud/lime mortar ☐ Cohesive □ <25% □ 25-50% ■ Non-cohesive □ Stone masonry High: □ 50-75% □ 75-100% □100% 8700D Others % of sub-type per facade Condition Sub-type □ 25-50% <25<sup>∞</sup> Walls sitting on natural unmodified ground □ 50-75% □ 75-100% □100% Load bearing masonry/quincha walls (Skip if roof sector) Identify locations of wall materials on plan Approx. # of walls of sub-Graphic at plan Sub-type Details type/total # of walls ☐ Mark here if ☐ With mud mortar $\Box$ 1 = All walls $\Box$ 1/2 of walls system is (probably original) $\square$ 3/4 of walls $\square$ 1/4 of walls □ Adobe masonry walls: assumed only Dimensions: With mud mortar and Mortar: $\Box$ 1 = All walls $\Box$ 1/2 of walls insertions of bricks $\square$ 3/4 of walls $\square$ 1/4 of walls with cement mortar $\Box$ 1 = All walls $\Box$ 1/2 of walls ☐ Rammed earth walls $\square$ 3/4 of walls $\square$ 1/4 of walls ☐ With cement mortar $\Box$ 1 = All walls $\Box$ 1/2 of walls ☐ Brick masonry walls ☐ With lime mortar $\square$ 3/4 of walls $\square$ 1/4 of walls $\Box$ 1 = All walls $\Box$ 1/2 of walls ☐ With mud mortar $\square$ 3/4 of walls $\square$ 1/4 of walls ☐ Stone masonry walls □ With lime/cement $\Box$ 1 = All walls $\Box$ 1/2 of walls mortar $\square$ 3/4 of walls $\square$ 1/4 of walls

Date of survey:









		☐ With cane reed (part of original construction)	f $\Box$ 1 = All walls $\Box$ 1/2 of walls $\Box$ 3/4 of walls $\Box$ 1/4 of walls	0 0
	☐ Quincha walls with wooden frames	☐ With adobe blocks infill	$\Box$ 1 = All walls $\Box$ 1/2 of walls $\Box$ 3/4 of walls $\Box$ 1/4 of walls	<i>0///////</i> 0
		□ With brick infill	$\Box$ 1 = All walls $\Box$ 1/2 of walls $\Box$ 3/4 of walls $\Box$ 1/4 of walls	0 0
Previous structural red dentify locations of wa				
	Sub-type	Details	Approx. # of walls of sub- type/total # of walls	Graphic at plan
	☐ Reinforced masonry	☐ Brick with embedded concrete columns	$\Box$ 1 = All walls $\Box$ 1/2 of walls $\Box$ 3/4 of walls $\Box$ 1/4 of walls	
	walls	☐ Adobe blocks with embedded concrete columns	$\Box$ 1 = All walls $\Box$ 1/2 of walls $\Box$ 3/4 of walls $\Box$ 1/4 of walls	
	☐ Concrete frame with unreinforced masonry	□ Brick	$\Box$ 1 = All walls $\Box$ 1/2 of walls $\Box$ 3/4 of walls $\Box$ 1/4 of walls	
	walls	□ Adobe	$\Box$ 1 = All walls $\Box$ 1/2 of walls $\Box$ 3/4 of walls $\Box$ 1/4 of walls	
			Location	Graphic at plan
		☐ Iron/Steel bars	□ Across walls □ Inside walls	•
		☐ Anchors	☐ Top to roof ☐ Wall to wall	X
		☐ Wooden keys		4
	☐ Reinforcements	☐ Isolated concrete beams	☐ Longer walls ☐ Shorter walls ☐ Across the room ☐ Around the room	
		☐ Wooden beams	☐ Longer walls ☐ Shorter walls ☐ Across the room	
			☐ Around the room	
	so for roof sector) Identify loc.	itions of plaster types on plan.	☐ Around the room	
	so for roof sector) Identify loca	ations of plaster types on plan.  Details	M Around the room  % of sub-type on all walls per sector	Graphic at plan
	Sub-type		% of sub-type on all walls	Graphic at plan
Could be applicable al		Details	% of sub-type on all walls  per sector   25% 25-50%	Graphic at plan
n walls	Sub-type	<b>Details</b> ☐ Painted	% of sub-type on all walls per sector  □ <25% □ 25-50% □ 50-75% □ 75-100% □100% □ <25% □ 25-50%	Graphic at plan
ould be applicable al en walls □ Yes	Sub-type   Mud/Lime plaster	<b>Details</b> ☐ Painted	% of sub-type on all walls per sector  □ <25% □ 25-50% □ 50-75% □ 75-100% □ 100% □ <25% □ 25-50% □ 50-75% □ 75-100% □ 100% □ <25% □ 25-50%	Graphic at plan
n walls	Sub-type  Mud/Lime plaster  Cement plaster  Painted surface only	<b>Details</b> ☐ Painted	% of sub-type on all walls per sector  □ <25% □ 25-50% □ 50-75% □ 75-100% □ 100% □ <25% □ 25-50% □ 50-75% □ 75-100% □ 100% □ <25% □ 25-50% □ 50-75% □ 75-100% □ 100% □ <25% □ 25-50%	Graphic at plan
on walls  ☐ Yes ☐ No	Sub-type  Mud/Lime plaster  Cement plaster	Details  Painted  Not-painted	% of sub-type on all walls per sector  □ <25% □ 25-50% □ 50-75% □ 75-100% □ 100% □ <25% □ 25-50% □ 50-75% □ 75-100% □ 100% □ <25% □ 25-50% □ 50-75% □ 75-100% □ 100% □ <25% □ 25-50% □ 50-75% □ 75-100% □ 100% □ <25% □ 25-50% □ 50-75% □ 75-100% □ 100%	Graphic at plan
Could be applicable al	Sub-type  Mud/Lime plaster  Cement plaster  Painted surface only	Details  Painted  Not-painted	% of sub-type on all walls per sector  □ <25% □ 25-50% □ 50-75% □ 75-100% □ 100% □ <25% □ 25-50% □ 50-75% □ 75-100% □ 100% □ <25% □ 25-50% □ 50-75% □ 75-100% □ 100% □ <25% □ 25-50% □ 50-75% □ 75-100% □ 100% □ <25% □ 25-50% □ 50-75% □ 75-100% □ 100% □ <25% □ 25-50% □ 50-75% □ 25-50% □ 50-75% □ 25-50%	Graphic at plan

# Earthen Architecture Initiative

# Structural Assessment Survey Form – Seismic Retrofitting Project in Peru (SRP)









(Skip if roof sector or last floor)  Direction @ longer wall. # and dimensions	Sub-type	Details
Parallel; #: Indicate in plan: Dimensions:	□ With wooden beams and rafters	<ul> <li>☐ Mud plaster or not + wooden structure + mud cover + wooden floors</li> <li>☐ Mud plaster or not + wooden structure + cement cover + other type of floor</li> </ul>
Structural elements: m.  Space between them: m.		
Indicate in plan:	☐ With concrete beams and rafters	<ul> <li>Mud plaster or not + wooden structure + mud cover + wooden floors</li> <li>Mud plaster or not + wooden structure + cement cover + other type of floor</li> </ul>
Roofing		
	Sub-type	Details
□ Parallel; #:		☐ Wood rafters, tie beam, collar beam, wall plate, mud plaster, cane, mud cover and straw.
Indicate in plan:		☐ Wood rafters, tie beam, collar beam, wall plate, mud plaster, cane, mud cover and tiles.
	□ Par y Nudillo	☐ Wood rafters, tie beam, collar beam, wall plate, cane, mud cover and tiles.
Dimensions: Structural elements: m.		☐ Wood rafters, tie beam, collar beam, wall plate, cane and tiles.
Space between them: m.		☐ Wood rafters, tie beam, collar beam, wall plate, cane, cement cover and tiles.
	☐ Concrete structure	Flat
☐ Perpendicular, #:		☐ Two eaves
Indicate in plan:	☐ Quincha vault/dome: Wooden frame, ribs and	☐ With cane planks laid across wooden arches and mud mortar ☐ With cane planks laid across wooden arches and
	arches	cement mortar
Dimensions:		☐ With mud plaster, wooden beams and joists, and mud cover.
Structural elements: m.	☐ Flat	☐ With wooden beams and joists, and mud cover
Space between them: m.		☐ With mud plaster, wooden beams and joists, and cement cover.
	□ Other	Describe:









The Getty Conservation Institute

# VII. Conditions impacting seismic performance of sector:

General impression:	☐ Stable	□ Instable

General Impression			
Adobe/Quincha walls			
Conditions:	In relation to the longer wall	Location	Graphic at plan
Total wall collapse	□ Yes □ No	☐ All walls ☐ ½ of walls ☐ 3/4 of walls ☐ 1/4 of walls	
Partial wall collapse (no consider plaster)	□Yes □No	☐ At the center☐ At the corners☐ Upper section	
Settlement of walls:	□Yes □No	☐ Center ☐ Edges	
Corner damage: (The "V" thing, incipient corner collapse)	☐ Yes ☐ No	□ All height □ Upper	
Out of plane displacement:  Yes  No	□Inward □Outward □Bowing	□ Lower □ Upper □ Middle	
	□ Horizontal	☐ Lower ☐ Upper ☐ Center	<b>\</b>
	□ Vertical	☐ Lower☐ Upper☐ Center☐ Coming out of openings☐ At corners	
Structural cracking:  Yes  No	□ Flexural	□ Wall to wall □ Wall to mid- wall	
	□ Diagonal	☐ Top to bottom☐ Top to mid-height☐ Bottom to mid-height	~ /
	□ X-Shaped	☐ Top to bottom☐ Top to mid-height☐ Bottom to midheight	
Cathedral of Ica – SECTOR #	Date of survey: /	/ By: □AF / □SL / □CC /	/









Conditions:	Details	Graphic at plan	% of sub-type on all walls per sector
Plaster loss: □ Yes □ No	☐ Center☐ Corners☐ Lower☐ Upper		□ <25% □ 25-50% □ 50-75% □ 75-100% □ 100% of walls show plaster detachment
Detachment of plasters: ☐ Yes ☐ No	☐ Center ☐ Corners ☐ Lower ☐ Upper		□ <25% □ 25-50% □ 50-75% □ 75-100% □ 100% of walls show plaster loss
Beetle damage (Round isolated holes):  No Yes With: Disaggregation	☐ Center☐ Corners☐ Lower☐ Upper☐		□ <25% □ 25-50% □ 50-75% □ 75-100% □ 100% of walls show beetle damage
Erosion:  Yes  No	☐ Upper ☐ Center ☐ Lowers ☐ At corners Average depth of loss: ☐ <0.01 ☐ 0.01-0.05 ☐ > 0.05		□<25% □ 25-50% □ 50-75% □ 75-100% □ 100% of the facade show erosion
Moisture damage:  No Yes With: Detachment Blistering Disaggregation Erosion Discoloration Rising damp Mold Vegetation	☐ Center ☐ Corners ☐ Top ☐ Bottom		□ <25% □ 25-50% □ 50-75% □ 75-100% □ 100% of walls show moisture damage
Presence of vegetation:  ☐ Yes ☐ No	☐ Center☐ Corners☐ Top☐ Bottom☐		□ <25% □ 25-50% □ 50-75% □ 75-100% □ 100% of walls has vegetation
Cathedral of Ica – SECTOR #	Date of survey: / /	By: □AF / □SL / □C	CC / OLV / ODT / OEV / ODDA / OVN/ OCF









Wooden beams, rafters, quincha frames:						
Deformation: □ No	Floors					
Yes	□Joists (" <i>viguetas"</i> )	☐ Center☐ At intersection	□ <25% □ 25-50% □ 50-75% □ 75-100% □ 100% show deformation			
	□Beams ( <i>"vigas")</i>	☐ Center☐ At connections	□ <25% □ 25-50% □ 50-75% □ 75-100% □ 100% show deformation			
	Roof					
	□Rafters ( <i>"pares")</i>	☐ Center ☐ At the edges	□ <25% □ 25-50% □ 50-75% □ 75-100% □ 100% show deformation			
	☐ Purlins	☐ Center ☐ At the edges	□ <25% □ 25-50% □ 50-75% □ 75-100% □ 100% show deformation			
	☐ Ridge purlins ( <i>"Cumbrera"</i> )	☐ Center ☐ At the edges	□ <25% □ 25-50% □ 50-75% □ 75-100% □ 100% show deformation			
	□ Collar beam ( <i>"Nudillos"</i> )	☐ Center ☐ At the edges	□ <25% □ 25-50% □ 50-75% □ 75-100% □ 100% show deformation			
	□Arches/Ribs	☐ Center ☐ At the edges	□ <25% □ 25-50% □ 50-75% □ 75-100% □ 100% show deformation			
	Quincha frames					
	□Vertical posts □Diagonal posts	☐ Center ☐ At the edges	□ <25% □ 25-50% □ 50-75% □ 75-100% □ 100% show deformation			
Rotting:	Floors					
□ No □ Yes	□Joists (" <i>viguetas"</i> )	☐ Center☐ At intersection	□ <25% □ 25-50% □ 50-75% □ 75-100% □ 100% show rotting			
	□Beams ( <i>"vigas")</i>	☐ Center☐ At connections	□ <25% □ 25-50% □ 50-75% □ 75-100% □ 100% show rotting			
	Roof					
	□Rafters ( <i>"pares")</i>	☐ Center☐ At the edges	□ <25% □ 25-50% □ 50-75% □ 75-100% □ 100% show rotting			
	☐ Purlins	☐ Center ☐ At the edges	□ <25% □ 25-50% □ 50-75% □ 75-100% □ 100% show rotting			
	☐ Ridge purlins ( <i>"Cumbrera"</i> )	☐ Center ☐ At the edges	□ <25% □ 25-50% □ 50-75% □ 75-100% □ 100% show rotting			
Cathedral of Ica – SECTOR #	Date of survey: / /	By: □AF / □SL / □C	C / OLV / ODT / OEV / ODDA / OVN/ OCI			









		8	
	□ Collar beam ( <i>"Nudillos"</i> )	☐ Center ☐ At the edges	□ <25% □ 25-50% □ 50-75% □ 75-100% □ 100% show rotting
	□Arches/Ribs	☐ Center ☐ At the edges	□ <25% □ 25-50% □ 75-100% □ 100% show rotting
	Quincha frames		
	□Vertical posts □Diagonal posts	☐ Center☐ At the edges	□ <25% □ 25-50% □ 75-100% □ 100% show rotting
Termite damage:	Floors		
□ No □ Yes	□Joists (" <i>viguetas"</i> )	☐ Center☐ At intersection	□ <25% □ 25-50% □ 75-100% □ 100% show termite damage
<del></del> *****	□Beams ( <i>"vigas")</i>	☐ Center☐ At connections	□ <25% □ 25-50% □ 75-100% □ 100% show termite damage
	Roof		
	□Rafters ( <i>"pares")</i>	☐ Center ☐ At the edges	□ <25% □ 25-50% □ 75-100% □ 100% show termite damage
	☐ Purlins	☐ Center ☐ At the edges	□ <25% □ 25-50% □ 75-100% □ 100% show termite damage
	☐ Ridge purlins ( <i>"Cumbrera"</i> )	☐ Center☐ At the edges	□ <25% □ 25-50% □ 75-100% □ 100% show termite damage
	□ Collar beam ( <i>"Nudillos"</i> )	☐ Center ☐ At the edges	□ <25% □ 25-50% □ 75-100% □ 100% show termite damage
	□Arches/Ribs	☐ Center ☐ At the edges	□ <25% □ 25-50% □ 75-100% □ 100% show termite damage
	Quincha frames		
	□Vertical posts □Diagonal posts	☐ Center☐ At intersection	□ <25% □ 25-50% □ 50-75% □ 75-100% □ 100% show termite damage
	Adobe masonry - (Us	ually located at the bo	ottom of the façade)
	☐ Yes ☐ No	□ All façade □ Corners □ Center	□ <25% □ 25-50% □ 75-100% □ 100% show termite damage
Connections			
Corrosion on metal anchors/nails:	□Anchors	<ul><li>□ Top of walls</li><li>□ Bottom</li></ul>	
Yes	□Bars	<ul><li>☐ Middle/Center</li><li>☐ At the edges</li></ul>	
Cathedral of Ica – SECTOR #	Date of survey: / /	By: □AF / □SL / □C	C / □LV / □DT / □EV / □DDA / □VN/ □









Failure/Disconnections:  No Yes	Wall to wall: □Edge connection □Internal T connection	□ All height □ Upper □ Lower	□ <25% □ 25-50% □ 50-75% □ 75-100% □ 100% show failure
	□Lintels	☐ Center ☐ At the edges	□ <25% □ 25-50% □ 75-100% □ 100% show failure
	□Floor/Wall connections	☐ Center ☐ At the edges	□ <25% □ 25-50% □ 50-75% □ 75-100% □ 100% show failure
	□Roof/Top of the wall connections	☐ Center ☐ At the edges	□ <25% □ 25-50% □ 75-100% □ 100% show failure











The Getty Conservation Institute

Building: Cathedral of Ica	Antiqua Catedrat
Address:	de ka
Facade:	
Type: ☐ Exterior / ☐ Interior/Patio/Courtyard	
Date of survey: / / (mm/dd/yy)	The state of the s

I. Location of facade (square) or cross section (line) in the building:

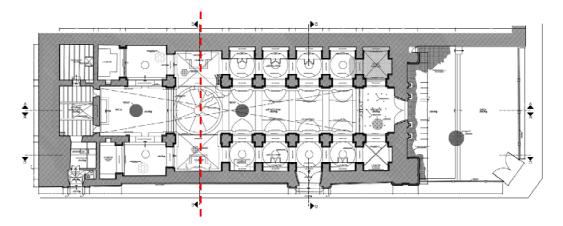

# II. Elevation of façade or cross section:

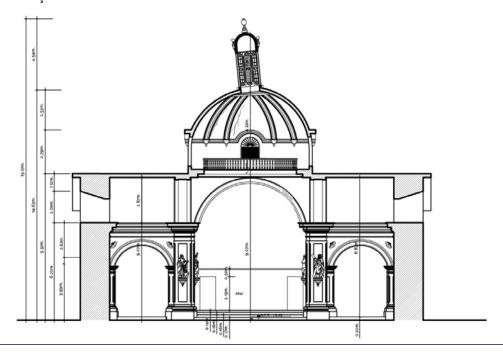









	Sedes Sapientiae	TEL PROJECT	DATTI	TY	The Getty Conservation Institute
III.Facade	photos or sketches:				









IV.General seismic performance and vulnerability	,
The total width of door and window openings in a sector wall is less than 1/3 of the distance between the adjacent cross walls:	Height-to-thickness ratio of the shear walls is:
□ Yes □No □NA	
Average story height:	Average ratio opening/walls:
Façade is restrained at diaphragm level by:    Joists   Rafters: Presence of:   Wall plate   Pins   Inca external anchor   External pin anchor   Embedded pin anchor   Others:	Type of openings:  Floor height #: Less than floor height #: Location:  Center: Yes No NA Close to the corners: Yes No NA Distributed evenly horizontally: Yes No NA Distributed evenly vertical: Yes No NA Other describe:
Façade connections at edges:	Façade connections with interior walls:
<ul> <li>□ Originally built full connection (complete woven with the wall)</li> <li>□ X connection</li> <li>□ T connection</li> <li>□ Adjacent with butt joints</li> </ul>	<ul> <li>□ Originally built full connection (complete woven with the wall)</li> <li>□ X connection</li> <li>□ T connection</li> <li>Adjacent with butt joints</li> </ul>
V. Indicate location of photographs of conditions tak (Façade and floor plan)	en (Section VII):
(Taçade and noor plan)	









The Getty Conservation Institute

#### VI. Description of structural system facade: Type **Foundations** Cimentación Sub-type **Details** % of sub-type per facade Condition ☐ Mark here if ☐ Cohesive system is ☐ Non-cohesive Solid Rock assumed only □ <25% □ 25-50% □ Natural Stiff soil □ 50-75% □ 75-100% □100% ☐ Structure rock ☐ Cohesive ■ Non-cohesive □ <25% □ 25-50% ☐ Rubble stone □ 50-75% □ 75-100% □100% ☐ Man made: Stone 7/////// "cimentación" with ☐ Cohesive mud/lime mortar ■ Non-cohesive □ <25% □ 25-50% ☐ Stone masonry □ 50-75% □ 75-100% □100% Sobrecimiento Details % of sub-type per facade Condition Sub-type ☐ Mark here if ☐ Cohesive ■ Non-cohesive system is □ <25% □ 25-50% assumed only ☐ Rubble stone □ 50-75% □ 75-100% □100% ıĭııiıi ☐ "Sobrecimiento" with mud/lime mortar ☐ Cohesive ■ Non-cohesive □ <25% □ 25-50% □ Stone masonry □ 50-75% □ 75-100% □100% Others Sub-type **Details** % of sub-type per facade Condition □ 25-50% □ <25% ☐ Walls sitting on natural unmodified ground □ 50-75% □ 75-100% □100% Load bearing masonry/quincha facades Sub-type **Details** Location within the facade Graphic at plan ☐ With mud mortar ☐ First floor (probably original) ☐ Second and third floor □ Adobe masonry walls ☐ With mud mortar and ☐ First floor insertions of bricks ☐ Second and third floor with cement mortar ☐ First floor □ Rammed earth walls ☐ Second and third floor ☐ First floor ☐ Brick masonry walls □ With cement mortar ☐ Second and third floor ☐ With mud mortar ☐ Second and third floor □ Stone masonry walls □ With lime/cement ☐ First floor

☐ With cane reed and

mud plaster (original)

mortar

☐ Quincha walls with

wooden frames

☐ Second and third floor

☐ Second and third floor

☐ First floor









		☐ With cane reed and cement plaster	□ First floor □ Second and third	l floor	
		☐ With adobe blocks infill and mud plaster	☐ First floor ☐ Second and third	l floor	
		☐ With adobe/brick infill and cement plaster	☐ First floor☐ Second and third	l floor	圍
	☐ Reinforced masonry	☐ Bricks with embedded concrete columns	☐ First floor☐ Second and third	l floor	報園 達
	walls	☐ Adobe blocks with embedded concrete	☐ First floor ☐ Second and third	l floor	444
	☐ Concrete frame with unreinforced masonry	□ Brick	☐ First floor ☐ Second and third	l floor	
	walls	☐ Adobe	☐ First floor ☐ Second and third	l floor	圉
Plaster					
	Sub-type	Details	% of sub-type on th	ne facade	Graphic at plan
	☐ Mud/Lime plaster	☐ Painted	□ <25% □ 25-50° □ 50-75% □ 75-10°		
☐ Yes		□ Not-painted	□ <25% □ 25-50° □ 50-75% □ 75-10°	0% □100%	
□ No	☐ Cement plaster		□ <25% □ 25-509 □ 50-75% □ 75-100		
	☐ Painted surface only		□ <25% □ 25-509 □ 50-75% □ 75-100		£
Balconies					
	Sub-type	Details	Structural descri	iption	Graphic at plan
□ Yes	☐ Jetty (enclosed)	☐ Across entire façade ☐ Part of the façade ☐ #: ☐ Corner	☐ Stone flooring ☐ Wooden flooring		
□ No	□ Open	☐ Across entire façade ☐ Part of the façade #: ☐ Corner	☐ Stone flooring ☐ Wooden flooring		
Buttresses		-	-	,	
	Sub-type and # per sector	Condition		Gra	phic at plan
			1	Gia	
		Masonry fabric: □ Good □ Fair	□ Poor	Gia	
	□ Adobe:	_ *		Gia	
	□ Adobe: #:	☐ Good ☐ Fair ☐ Originally built full conne	ection (complete	Gra	
□ Yes □ No		Good Fair Originally built full connection woven with the wall)	ection (complete	Gra	
	#:	☐ Good ☐ Fair ☐ Originally built full conneworen with the wall) ☐ Adjacent with butt joints ☐ Later addition, superficia  Masonry fabric: ☐ Good ☐ Fair	I connection	Gra	
		□ Good □ Fair □ Originally built full conne woven with the wall) □ Adjacent with butt joints □ Later addition, superficia  Masonry fabric: □ Good □ Fair □ Originally built full conne woven with the wall)	I connection		N BLUE
	#:	☐ Good ☐ Fair ☐ Originally built full connewoven with the wall) ☐ Adjacent with butt joints ☐ Later addition, superficia  Masonry fabric: ☐ Good ☐ Fair ☐ Originally built full conne	I connection  Poor ection (complete		N BLUE









	Masonry fabric:  ☐ Good ☐ Fair ☐ Poor ☐ Brick: ☐ Originally built full connection (comple woven with the wall)			IN BLACK
		☐ Adjacent with butt join	its	
		☐ Later addition, superfic	ial connection	
Porticos				
	Location @ other walls	Details	Numbers	
□ None	☐ Across part of the facade	☐ Brick/Stone ☐ Wood	#:	
	☐ Across half of the facade	☐ Brick/Stone ☐ Wood	#:	
	☐ Across all facade	☐ Brick/Stone ☐ Wood	#:	
	Length of portico vs. length of	facada		









The Getty Conservation Institute

#### Conditions impacting seismic performance of facade: VII. **□** Stable ☐ Instable General impression: Adobe/Quincha walls Conditions: **Details** Location Graphic at facade ☐ All floors Total collapse: ☐ Third floor ☐ Yes ☐ Second floor □ No ☐ First floor Partial collapse (no consider ☐ All facade ☐ Third floor plaster): □ ½ of facade ☐ Second floor ☐ Yes □ 3/4 of facade ☐ First floor □ No □ 1/4 of facade □ At corners Settlement of facade: ) □ Center ☐ Yes □ Edges □ No Corner damage: (The "V" thing) ☐ All height Yes □ Upper No ☐ Lower Out of plane displacement: □ Inward □ Upper □ Outward Yes □ Middle No ☐ Bowing ☐ At corners □Horizontal ☐ Lower Average ☐ Upper width: □ Center ☐ At the piers (between openings and end of the facade) ☐ At the spandrel ☐ From the openings Structural cracking: □ Yes □Vertical: ☐ Lower □ No ☐ Upper Average ☐ Center width: ☐ At the piers (between openings and end of the façade) ☐ At the spandrel ☐ From the openings □ At corners









	□Flexural		
		□ Wall to wall □ Wall to mid-wal	
	□Diagonal	☐ Top to bottom☐ Top to mid-heig☐ Bottom to mid-height	ht
		<ul><li>At the piers (between opening and end of the façade)</li><li>At the spandrel</li></ul>	ngs
	□ X-shaped	☐ Top to bottom☐ Top to mid-heig☐ Bottom to mid-height	ht
		<ul><li>□ At the piers (between opening and end of the façade)</li><li>□ At the spandrel</li></ul>	ngs
Plaster loss: □ Yes □ No	☐ Center☐ Corners☐ Lower☐ Upper☐ Everywhere		□ <25% □ 25-50% □ 50-75% □ 75-100% □ 100% of facade show plaster detachment
Detachment of plasters:  ☐ Yes ☐ No	☐ Center☐ Corners☐ Lower☐ Upper☐ Everywhere		□ <25% □ 25-50% □ 50-75% □ 75-100% □ 100% of facade show plaster loss
Erosion: □ Yes □ No	☐ Upper ☐ Center ☐ Lowers ☐ At corners Average depth of loss: ☐ <0.01 ☐ 0.01-0.05 ☐ > 0.05		□ <25% □ 25-50% □ 50-75% □ 75-100% □ 100% of the facade show erosion









Beetle damage, (Round isolated holes):  No Yes With: Disaggregation	☐ Center ☐ Corners ☐ Lower ☐ Upper		□ <25% □ 25-50% □ 50-75% □ 75-100% □ 100% of walls show beetle damage	
Moisture damage:  No Yes With: Detachment Blistering Disaggregation Erosion Discoloration Rising damp Mold Vegetation	☐ Center ☐ Corners ☐ Top ☐ Bottom		□ <25% □ 25-50% □ 50-75% □ 75-100% □ 100% of walls show moisture damage	
Presence of vegetation:  ☐ Yes ☐ No	☐ Center☐ Corners☐ Top☐ Bottom		□ <25% □ 25-50% □ 50-75% □ 75-100% □ 100% of walls has vegetation	
Wooden beams, rafters, quincha fra	mes:	•		
Deformation: □ No □ Yes	□Wall plate	☐ Center☐ At intersection	□ <25% □ 25-50% □ 50-75% □ 75-100% □ 100% show deformation	
	□Wooden lintels	☐ Center☐ At connections	□ <25% □ 25-50% □ 50-75% □ 75-100% □ 100% show deformation	
	□Rafters (" <i>Pares</i> ") Location:	☐ Center ☐ At the edges	□ <25% □ 25-50% □ 50-75% □ 75-100% □ 100% show deformation	
	□Joists (" <i>viguetas</i> ") Location:	☐ Center☐ At the edges	□ <25% □ 25-50% □ 50-75% □ 75-100% □ 100% show deformation	
	□Arches/Ribs	☐ Center☐ At the support	□ <25% □ 25-50% □ 50-75% □ 75-100% □ 100% show deformation	
	Quincha			
	□Vertical posts □Diagonal posts	☐ Center☐ At intersection	□ <25% □ 25-50% □ 75-100% □ 100% show deformation	
	Balconies			
	Drop of support	☐ At the edges☐ At the center	□ <25% □ 25-50% □ 75-100% □ 100% show drop of support	









	Floor deformation	☐ At the edges☐ At the center	□<25% □ 25-50% □ 50-75% □ 75-100% 100% of balconies show floor deformation		
Rotting:  No Yes	□Wall plate	☐ Center ☐ At intersection	□ <25% □ 25-50% □ 50-75% □ 75-100% □ 100% show rotting		
	□Wooden lintels	☐ Center☐ At connections	□ <25% □ 25-50% □ 50-75% □ 75-100% □ 100% show rotting		
	□Rafters (" <i>Pares</i> ") Location:	☐ Center☐ At the edges	□ <25% □ 25-50% □ 50-75% □ 75-100% □ 100% show rotting		
	□Joists (" <i>viguetas</i> ") Location:	☐ Center ☐ At the edges	□ <25% □ 25-50% □ 50-75% □ 75-100% □ 100% show rotting		
	□Arches/Ribs	☐ Center ☐ At the support	□ <25% □ 25-50% □ 50-75% □ 75-100% □ 100% show rotting		
	Quincha				
	□Vertical posts □Diagonal posts	☐ Center☐ At intersection	□ <25% □ 25-50% □ 75-100% □ 100% show rotting		
Termite damage (Evidence of termites wings, frass):  No Yes	□Wall plate	☐ Center☐ At intersection	□ <25% □ 25-50% □ 50-75% □ 75-100% □ 100% show termite damage		
	□Wooden lintels	☐ Center☐ At connections	□ <25% □ 25-50% □ 50-75% □ 75-100% □ 100% show termite damage		
	Quincha frames				
	□Vertical posts □Diagonal posts	☐ Center☐ At intersection	□ <25% □ 25-50% □ 50-75% □ 75-100% □ 100% show termite damage		
	Adobe masonry - (Usually located at the bottom of the façade)				
	□ Yes □ No	☐ All façade ☐ Corners ☐ Center	□ <25% □ 25-50% □ 50-75% □ 75-100% □ 100% show termite damage		
Connections					
Corrosion on metal anchors/nails):  No Yes	□Anchors	☐ Top of walls ☐ Bottom			
	□Bars	☐ Center ☐ At the edges			
Failure/Disconnections: □ No □ Yes	□" Cimentacion"	☐ Center☐ At the edges	□ <25% □ 25-50% □ 50-75% □ 75-100% □ 100% show failure		











□ "Sobrecimiento"	☐ Center☐ At the edges	□ <25% □ 25-50% □ 75-100% □ 100% show failure
Wall to wall: □Edge connection □Internal T connection	□ All height □ Upper □ Lower	□ <25% □ 25-50% □ 50-75% □ 75-100% □ 100% show failure
□Buttresses	□ All height □ Upper □ Lower	□ <25% □ 25-50% □ 75-100% □ 100% show failure
□ Wall plate	□ Partial □ All length of facade	□ <25% □ 25-50% □ 75-100% □ 100% show failure
□Lintels	☐ Center ☐ At the edges	□ <25% □ 25-50% □ 75-100% □ 100% show failure
□Floor/Façade connections	☐ Center☐ At the edges	□ <25% □ 25-50% □ 50-75% □ 75-100% □ 100% show failure
□Roof/Top of the facade connections	☐ Center☐ At the edges	□ <25% □ 25-50% □ 50-75% □ 75-100% □ 100% show failure

## **APPENDIX B**


## **Architectural Drawings**

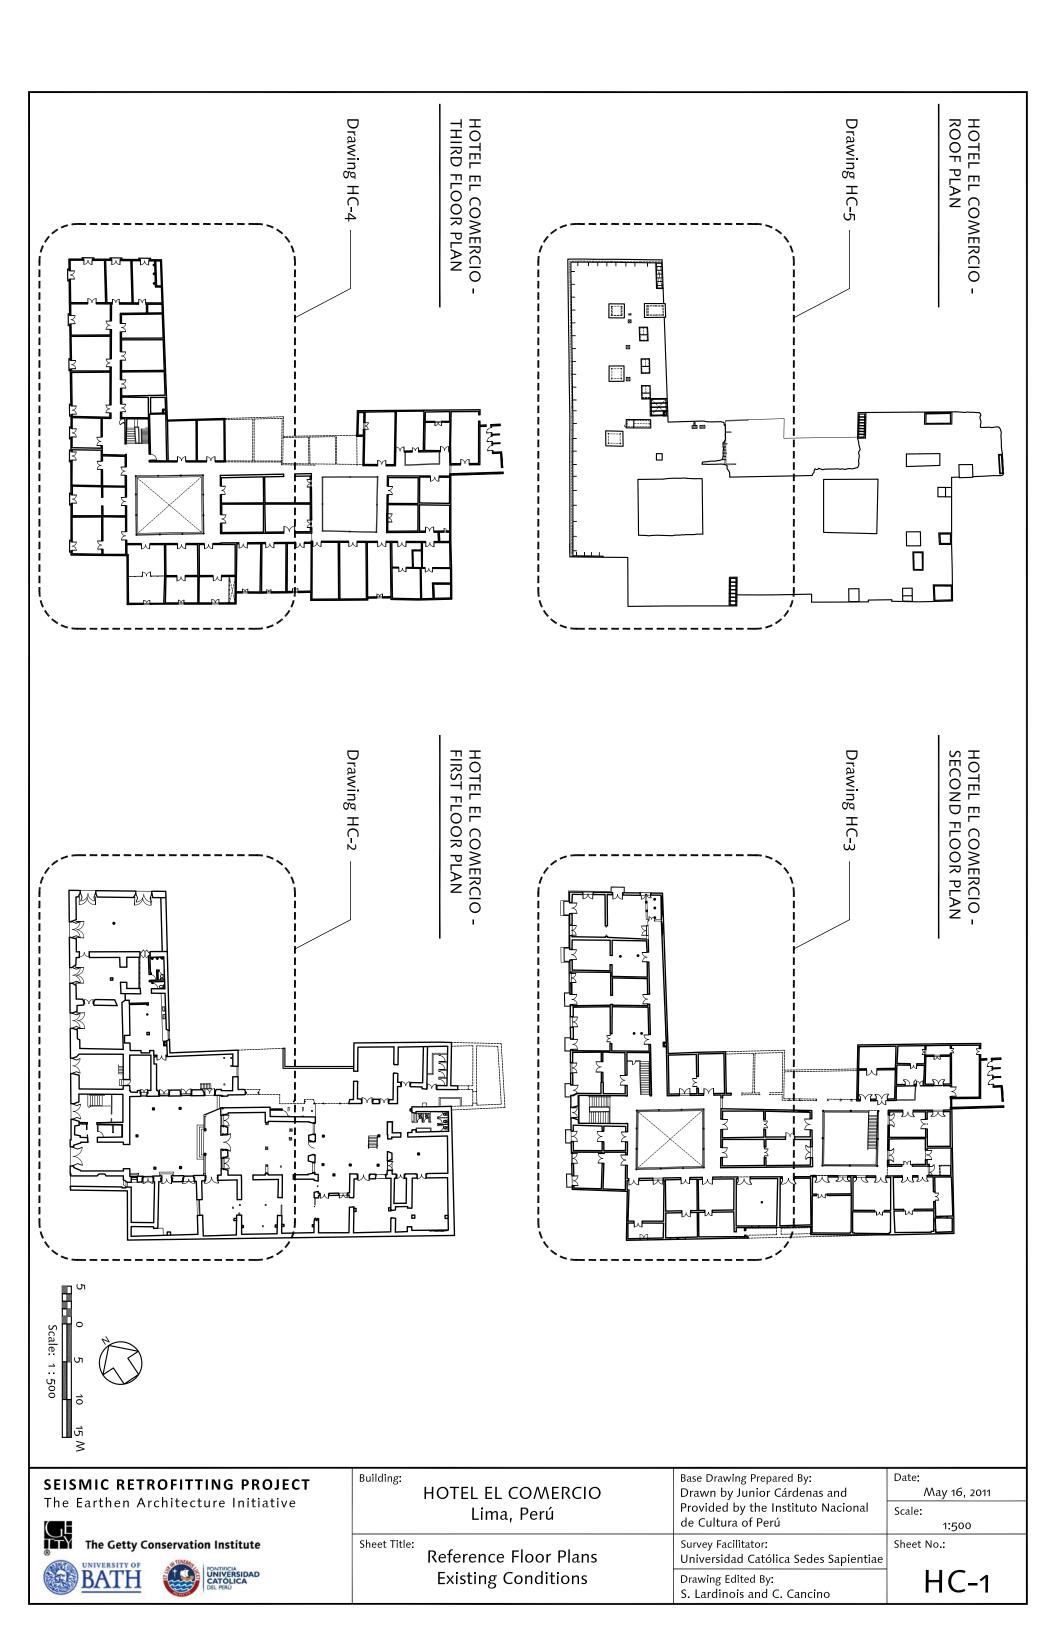

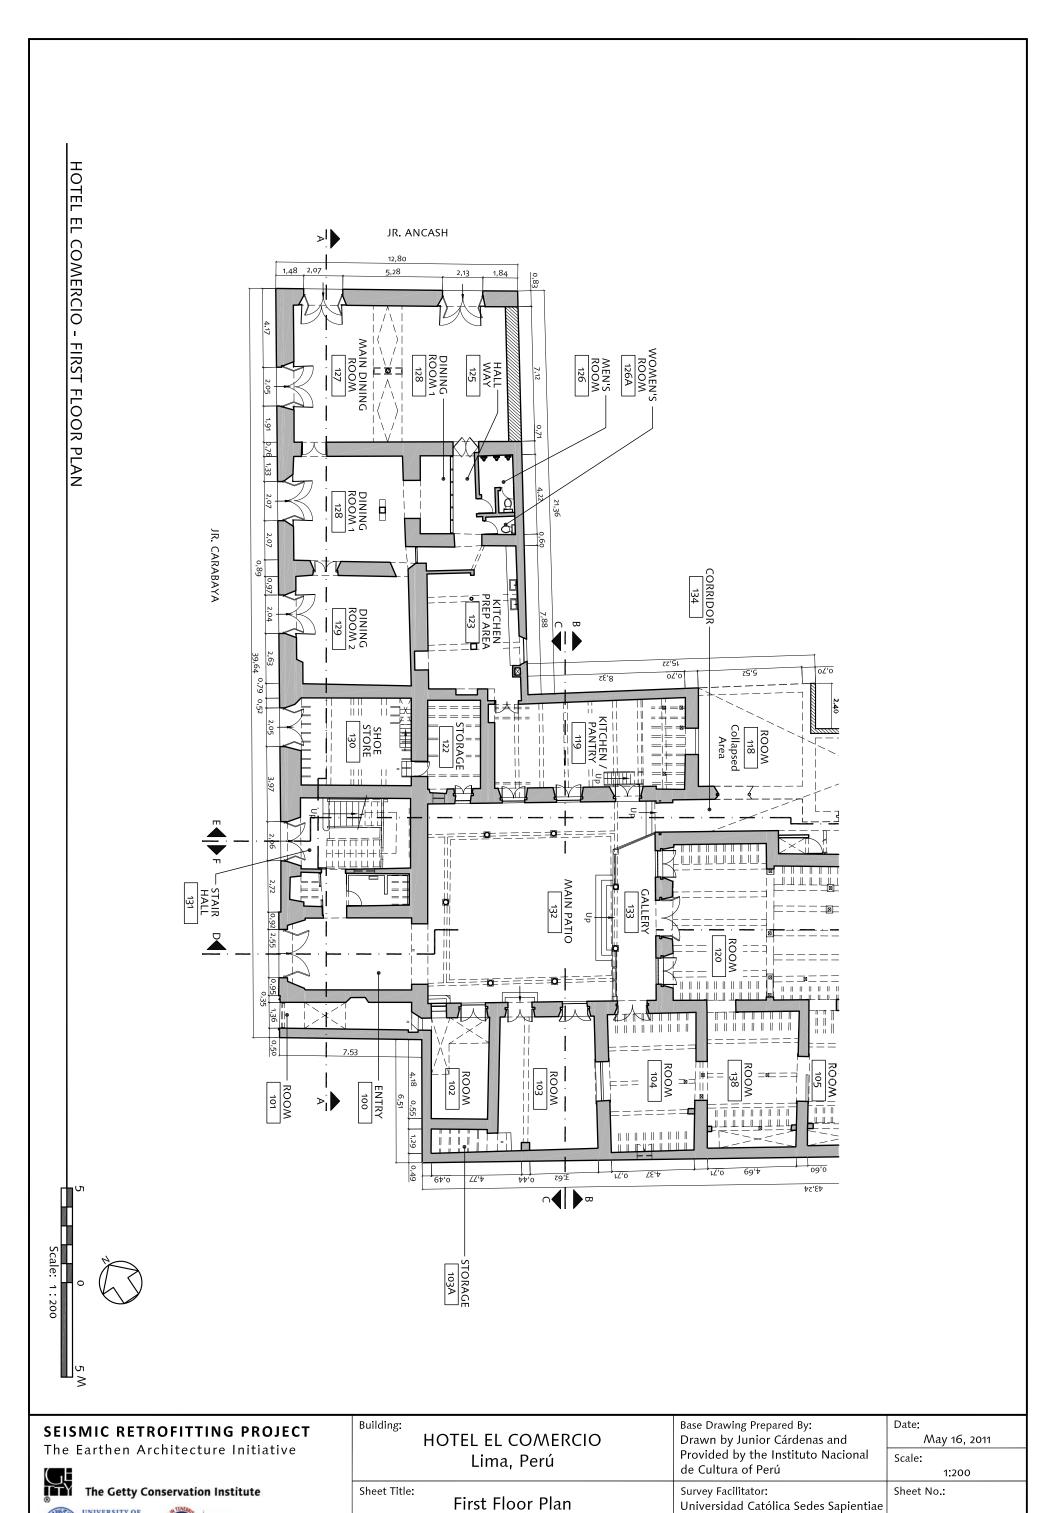


Drawing Edited By:


S. Lardinois and C. Cancino

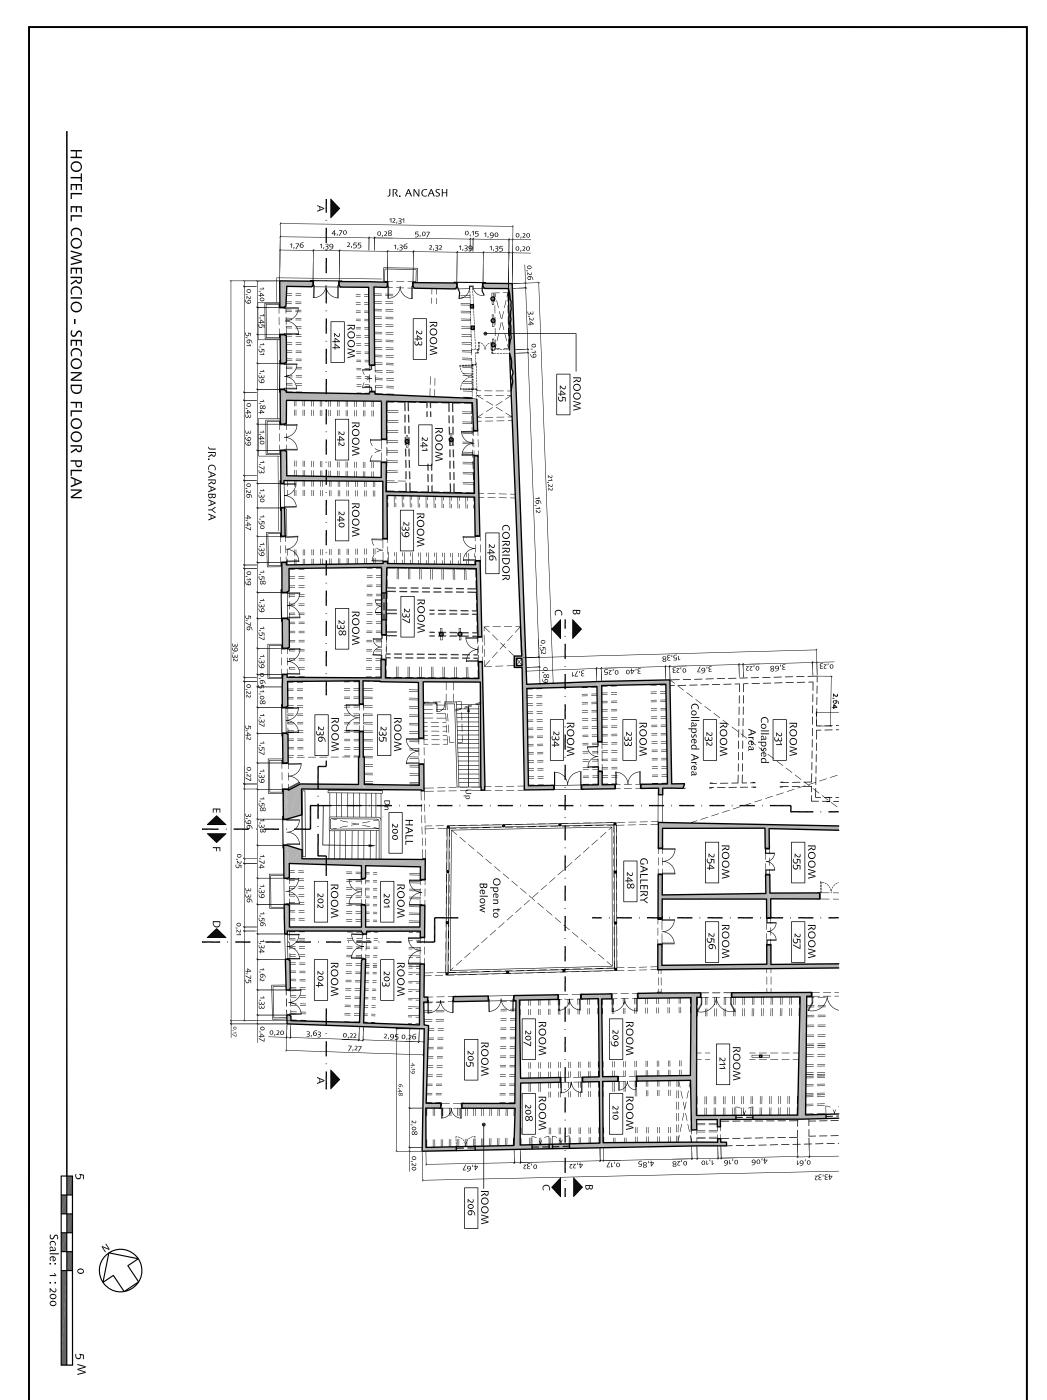





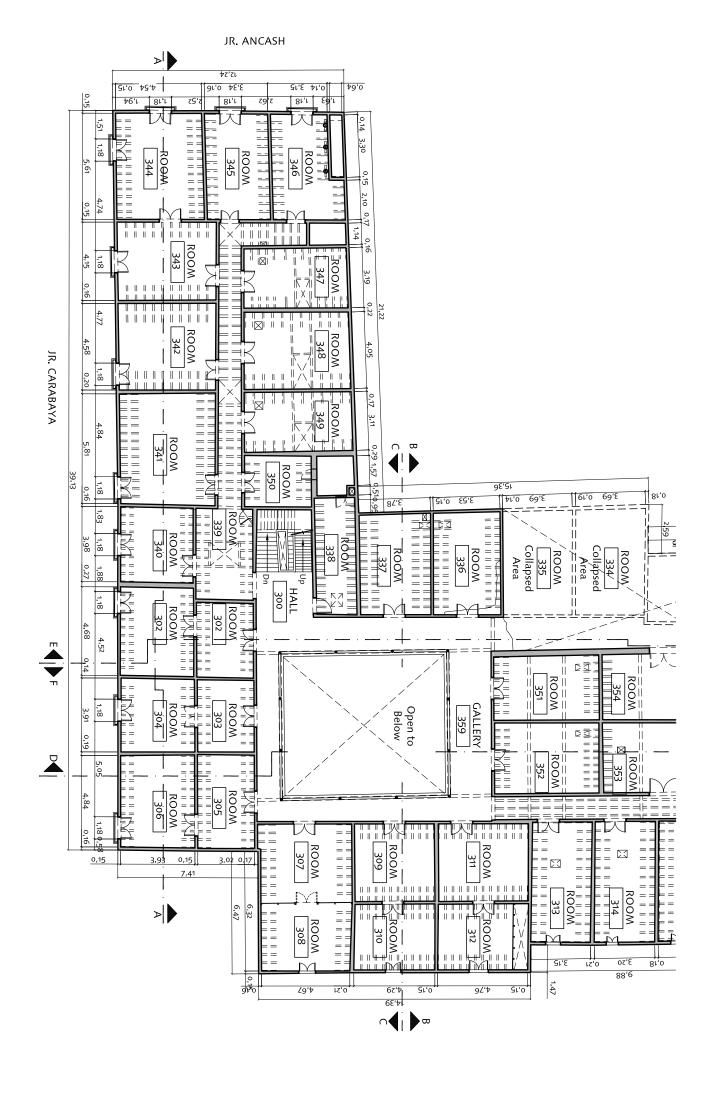

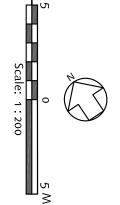

SEISMIC RETROFITTING PROJECT The Earthen Architecture Initiative

The Getty Conservation Institute

Building:	
_	HOTEL EL COMERCIO
	Lima, Perú

Third Floor Plan

**Existing Conditions** 

Sheet Title:


Base Drawing Prepared By:

Drawn by Junior Cárdenas and Provided by the Instituto Nacional de Cultura of Perú Survey Facilitator: Universidad Católica Sedes Sapientiae Drawing Edited By:

S. Lardinois and C. Cancino


Date: May 16, 2011 Scale: 1:200

Sheet No.:

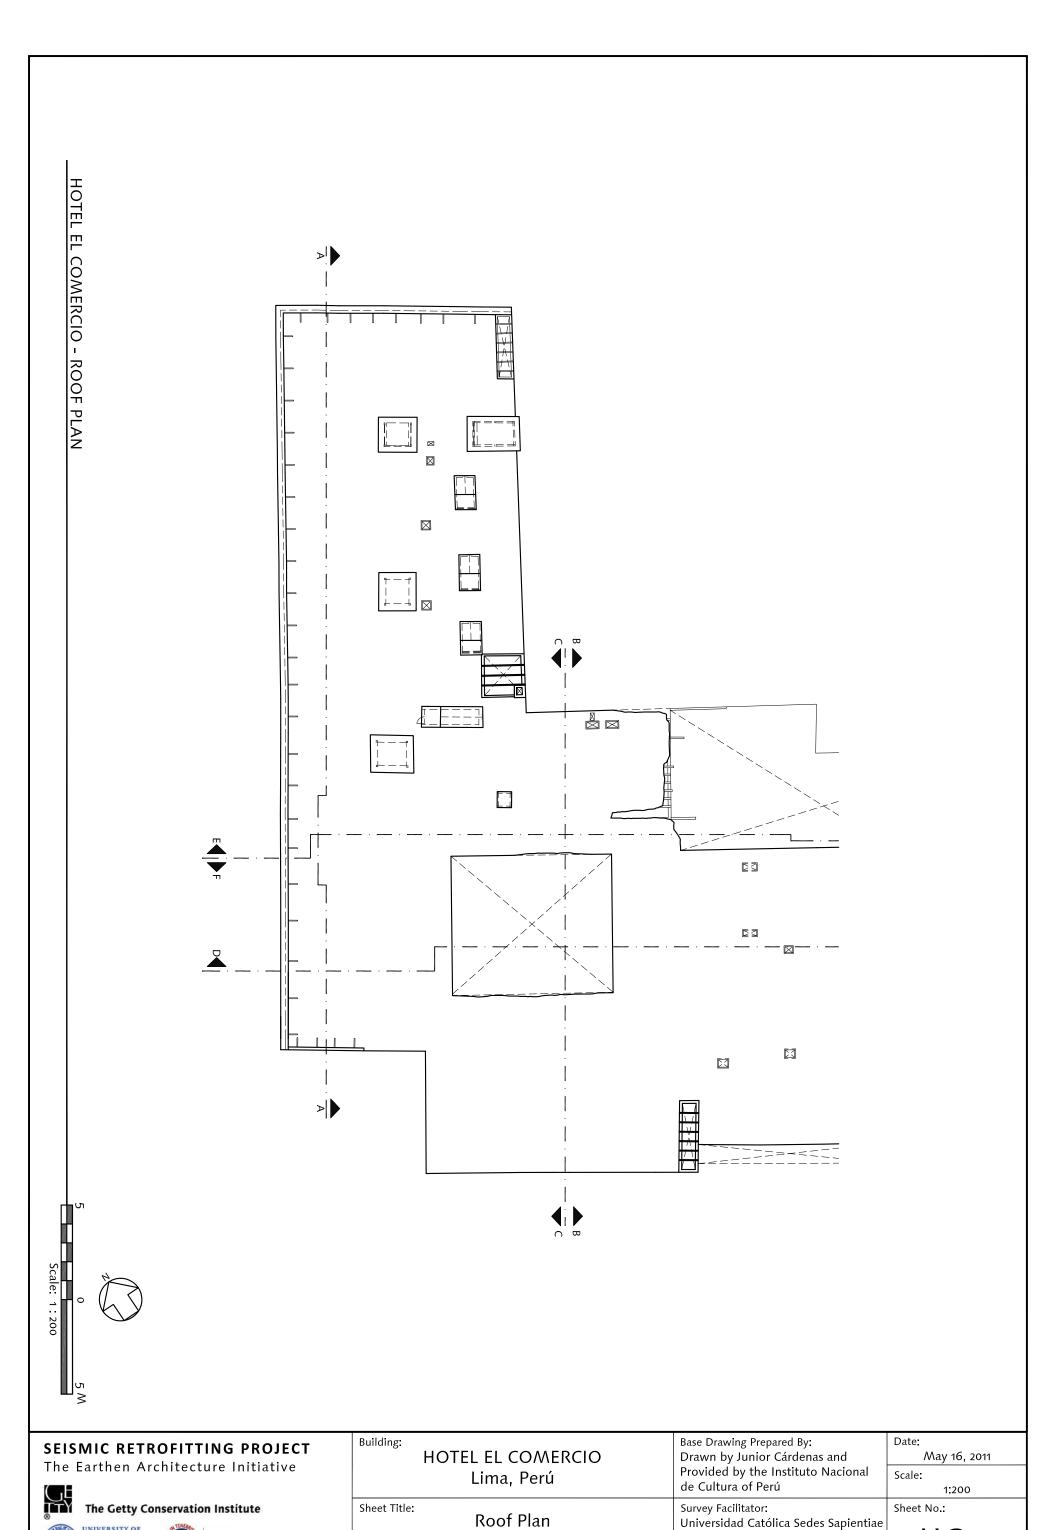


Drawing Edited By:

S. Lardinois and C. Cancino

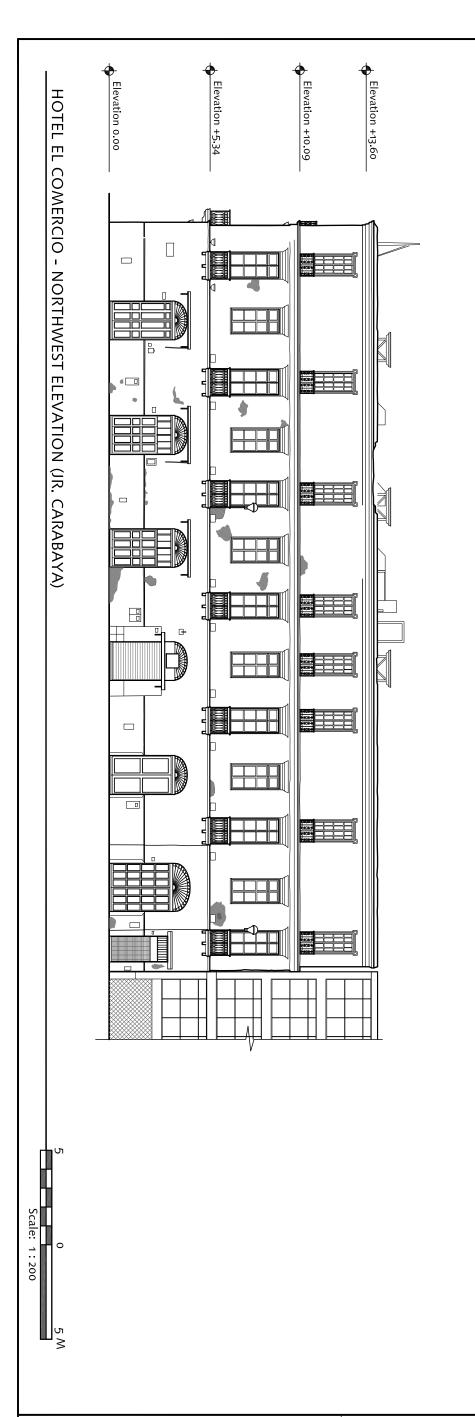

HOTEL EL COMERCIO - NORTHEST ELEVATION (JR. ANCASH)

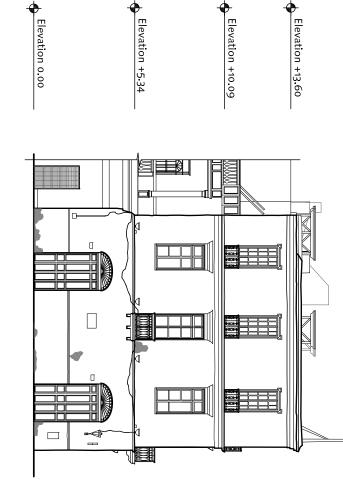

SEISMIC RETROFITTING PROJECT The Earthen Architecture Initiative

The Getty Conservation Institute

Building:

Sheet Title:

HOTEL EL COMERCIO Lima, Perú

**Exterior Elevations** 

**Existing Conditions** 


Drawn by Junior Cárdenas and Provided by the Instituto Nacional de Cultura of Perú Survey Facilitator: Universidad Católica Sedes Sapientiae Drawing Edited By:

Base Drawing Prepared By:

S. Lardinois and C. Cancino


Date: May 16, 2011 Scale: 1:200


Sheet No.:

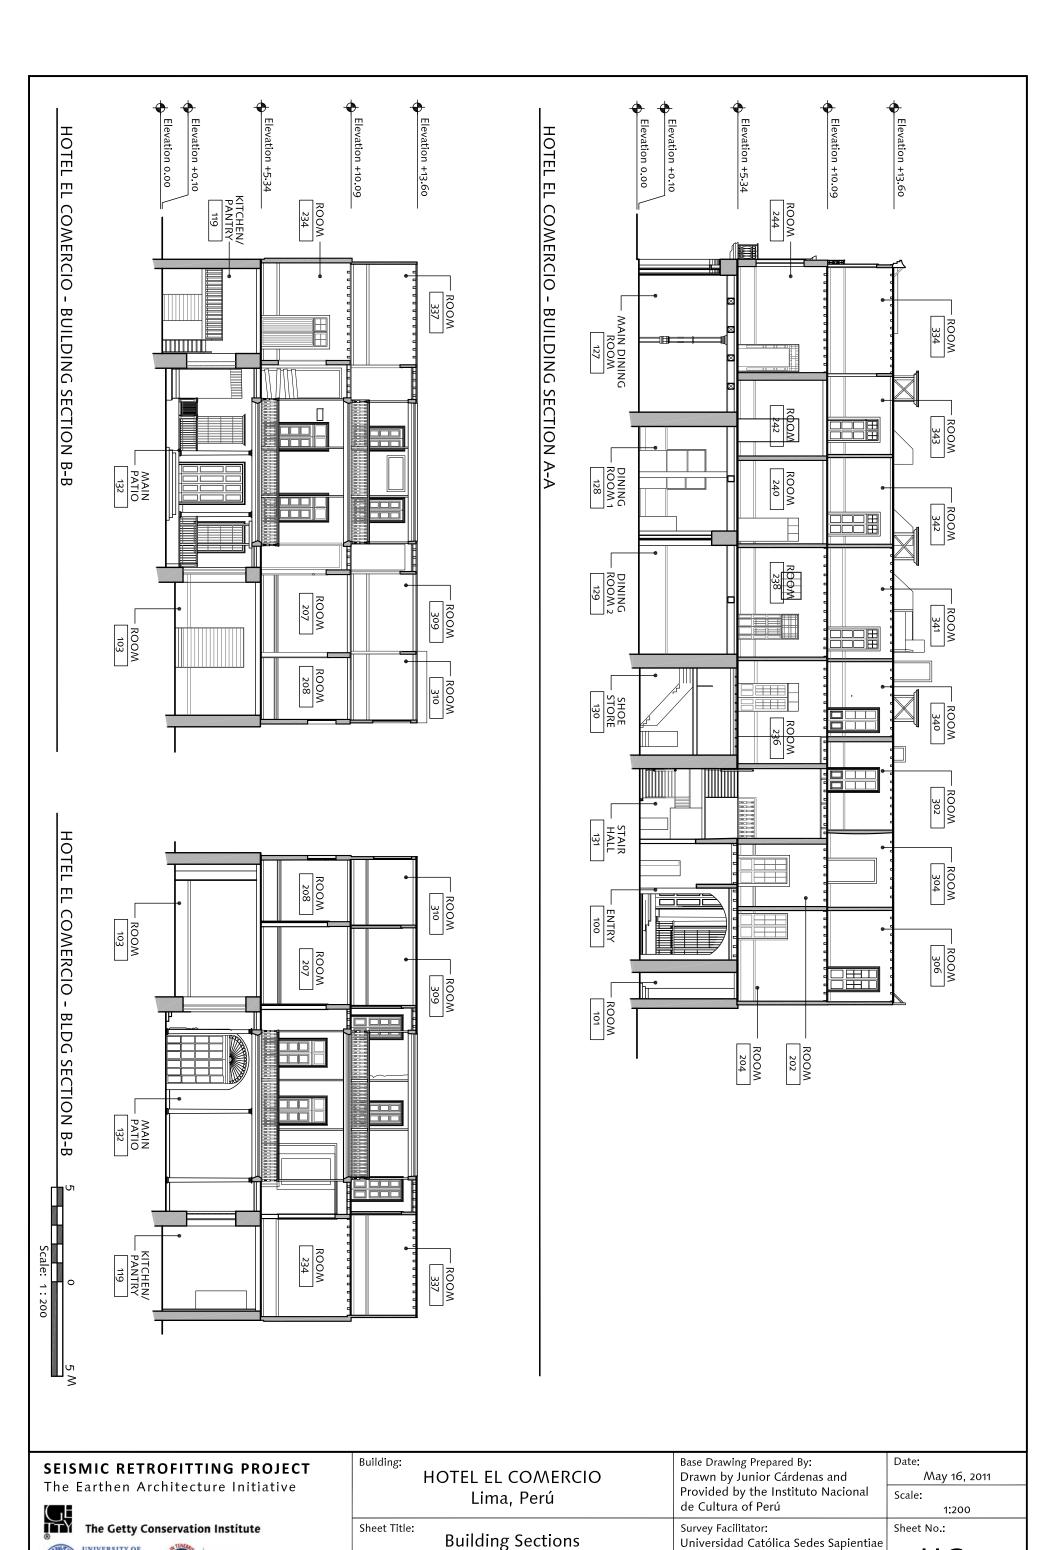



Drawing Edited By:


S. Lardinois and C. Cancino

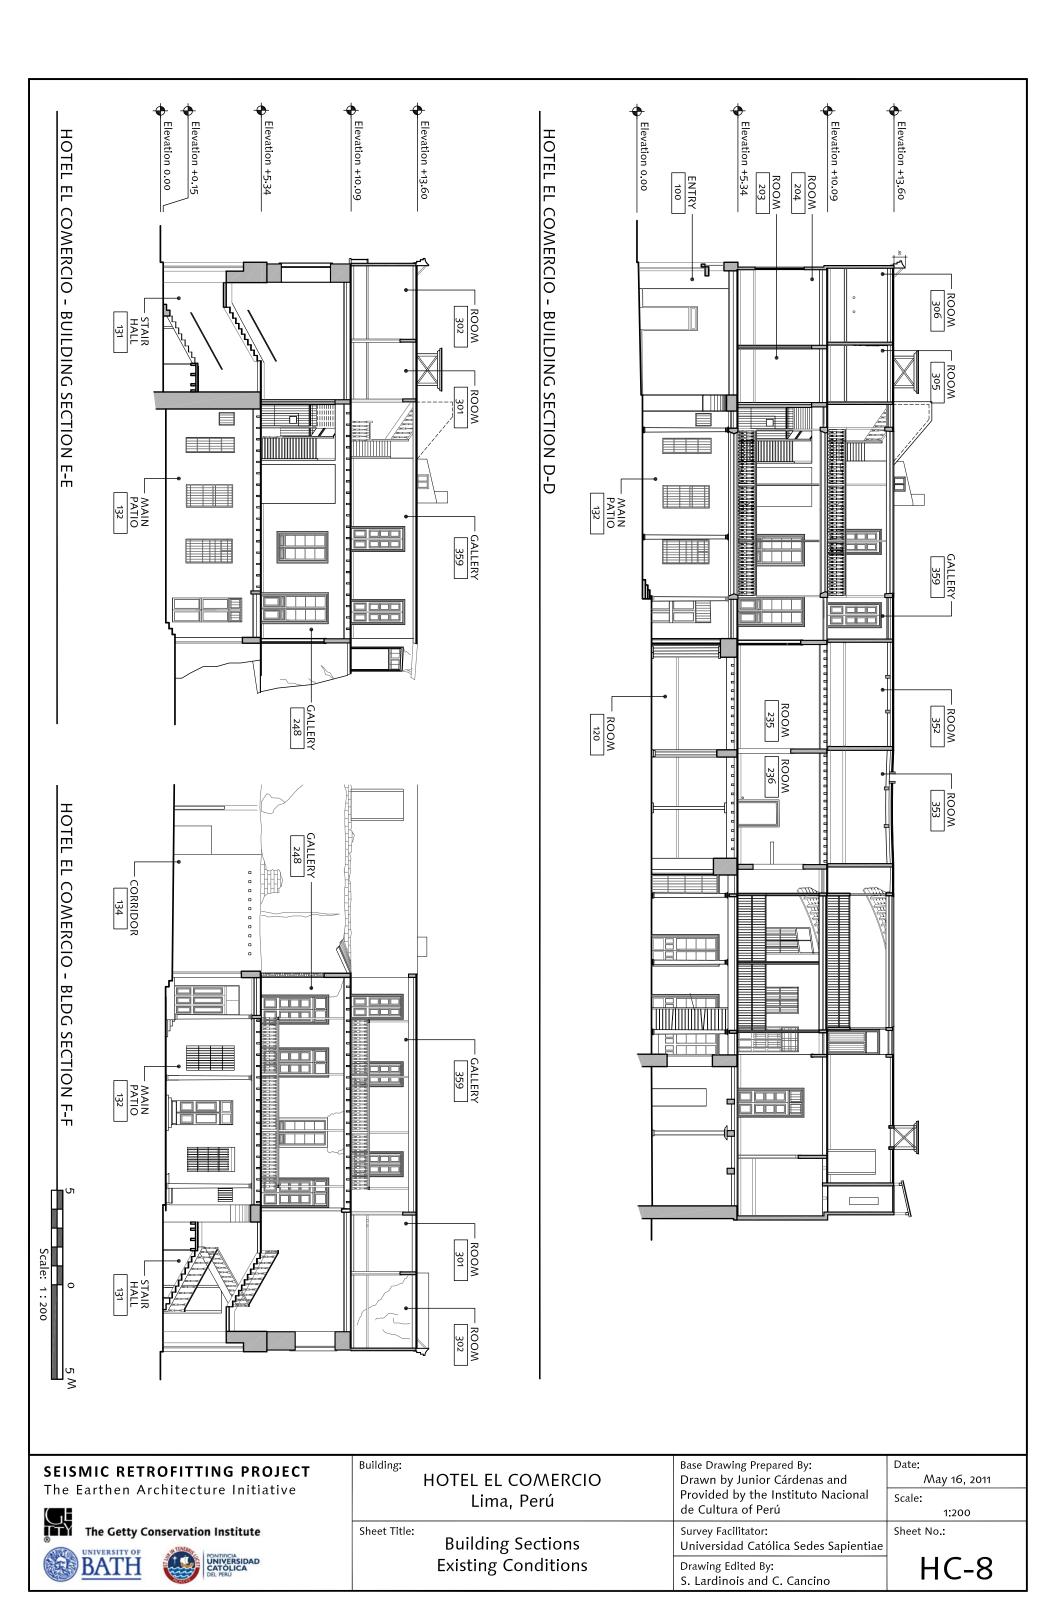

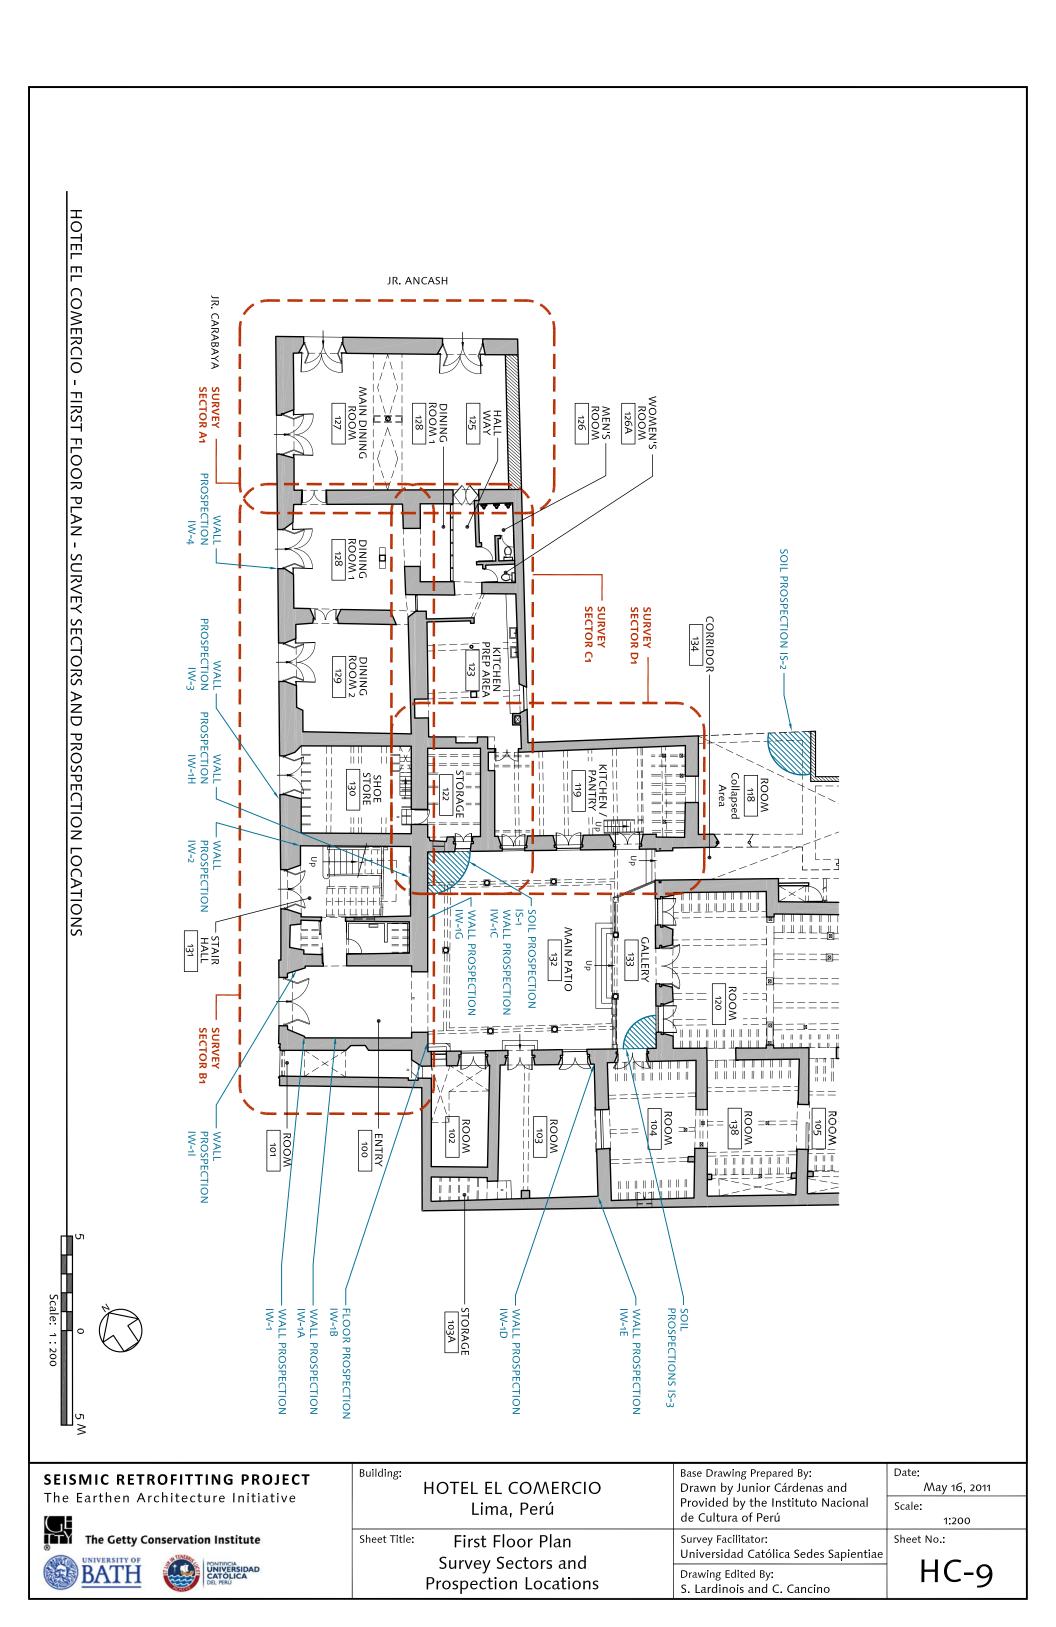


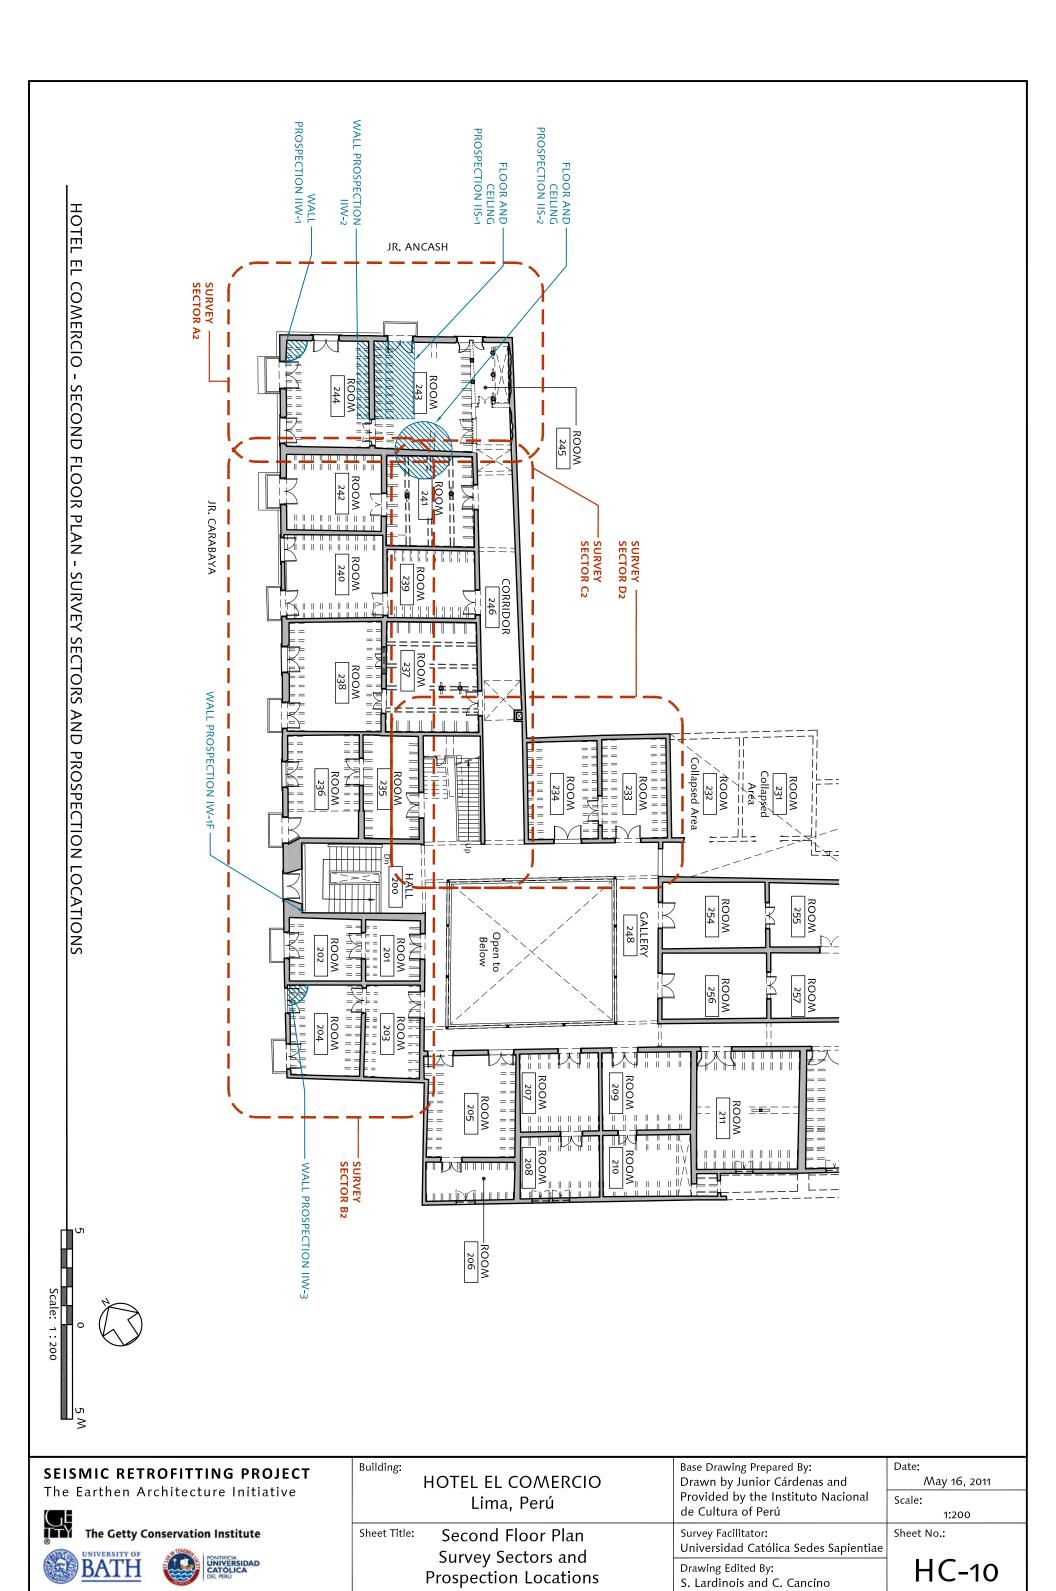

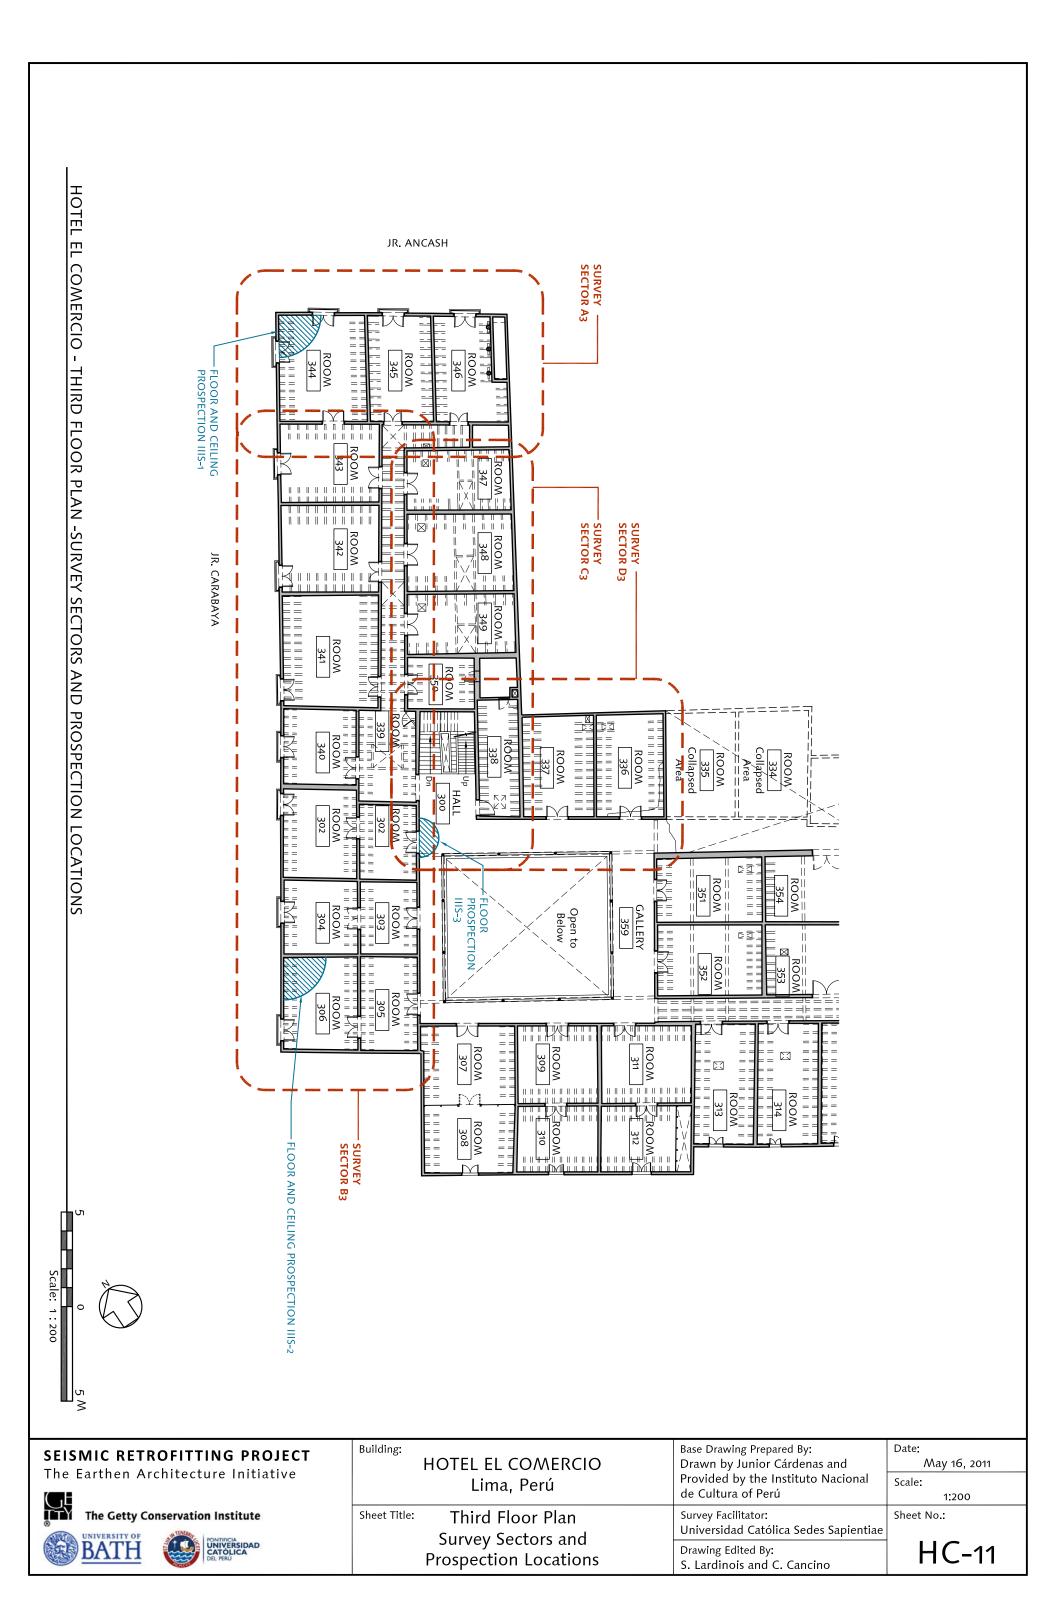

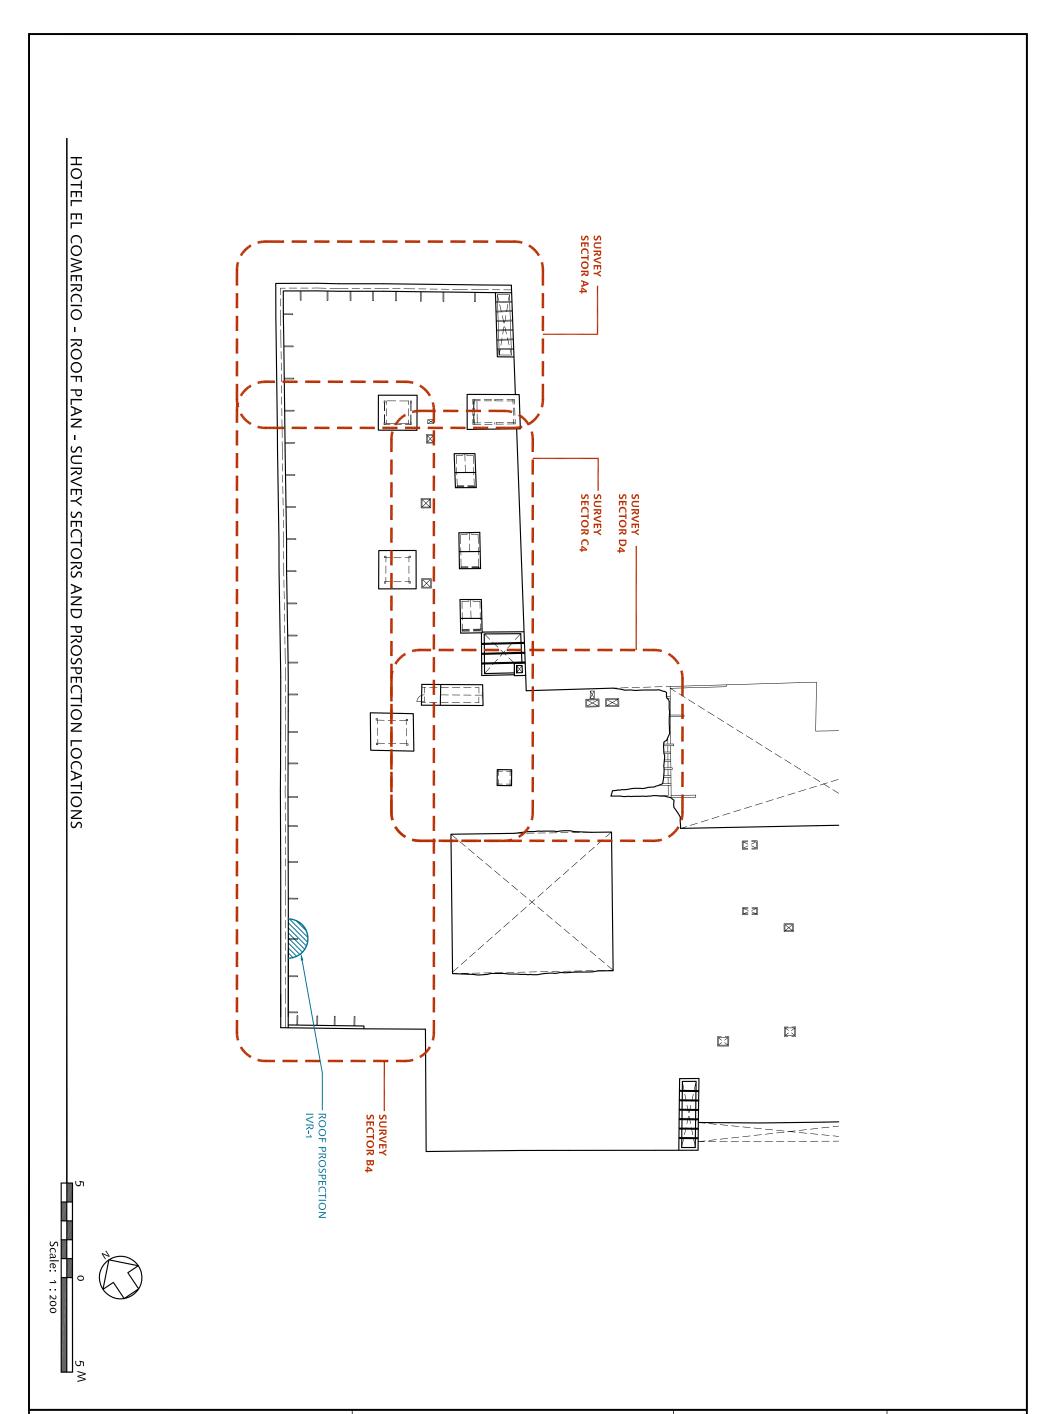




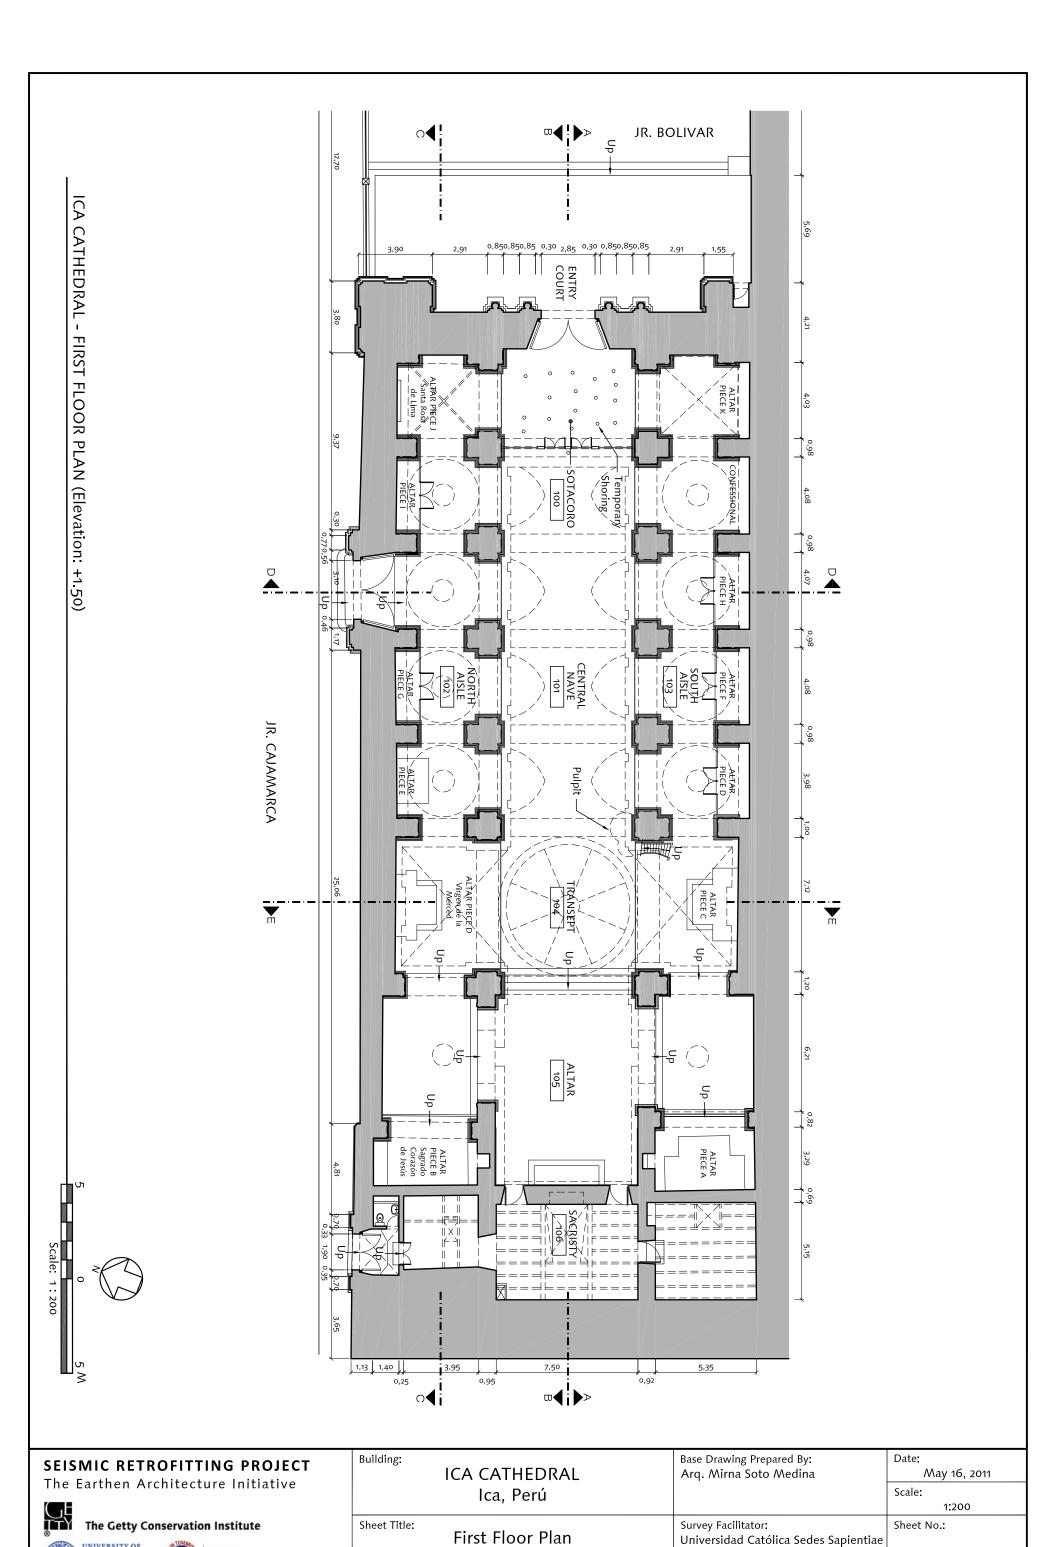


Drawing Edited By:


S. Lardinois and C. Cancino


IC-1

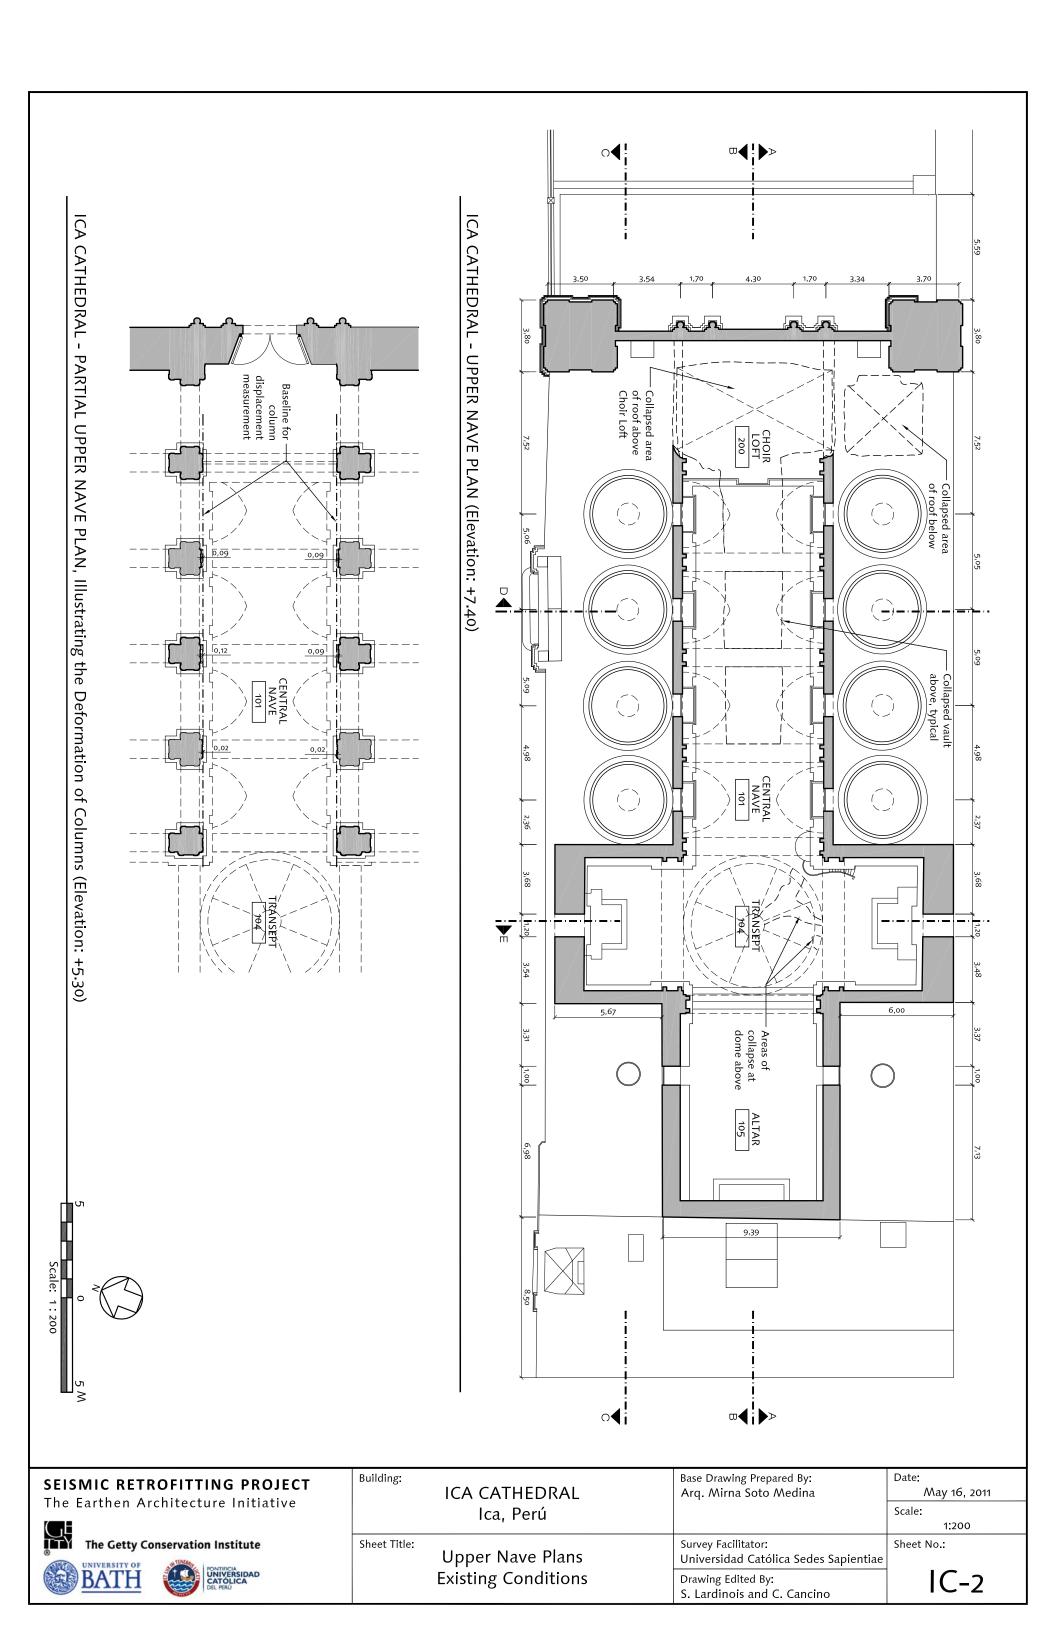

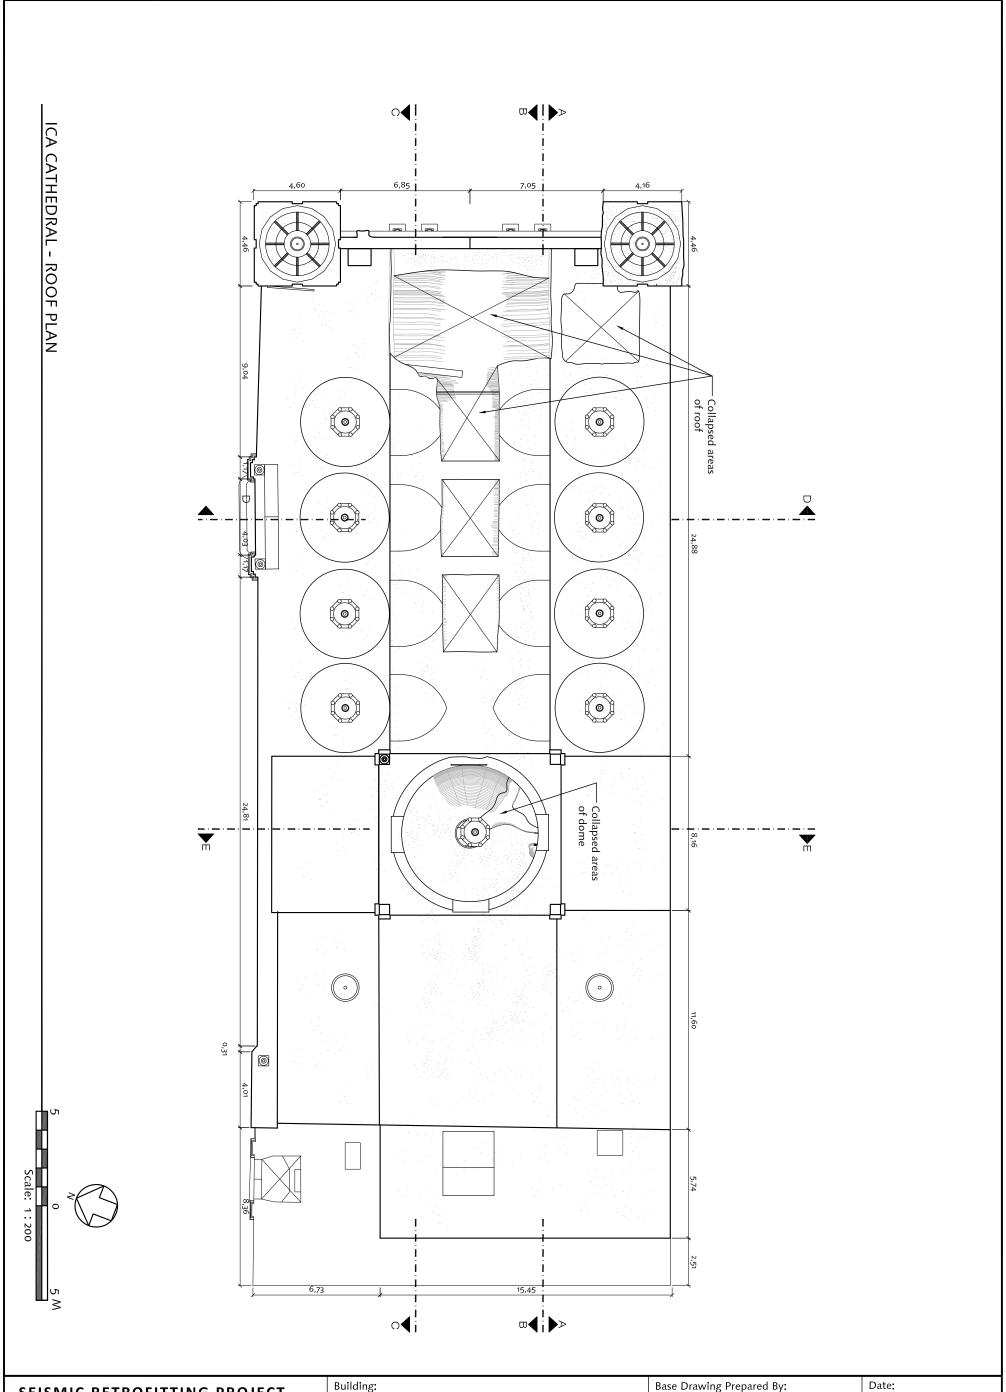



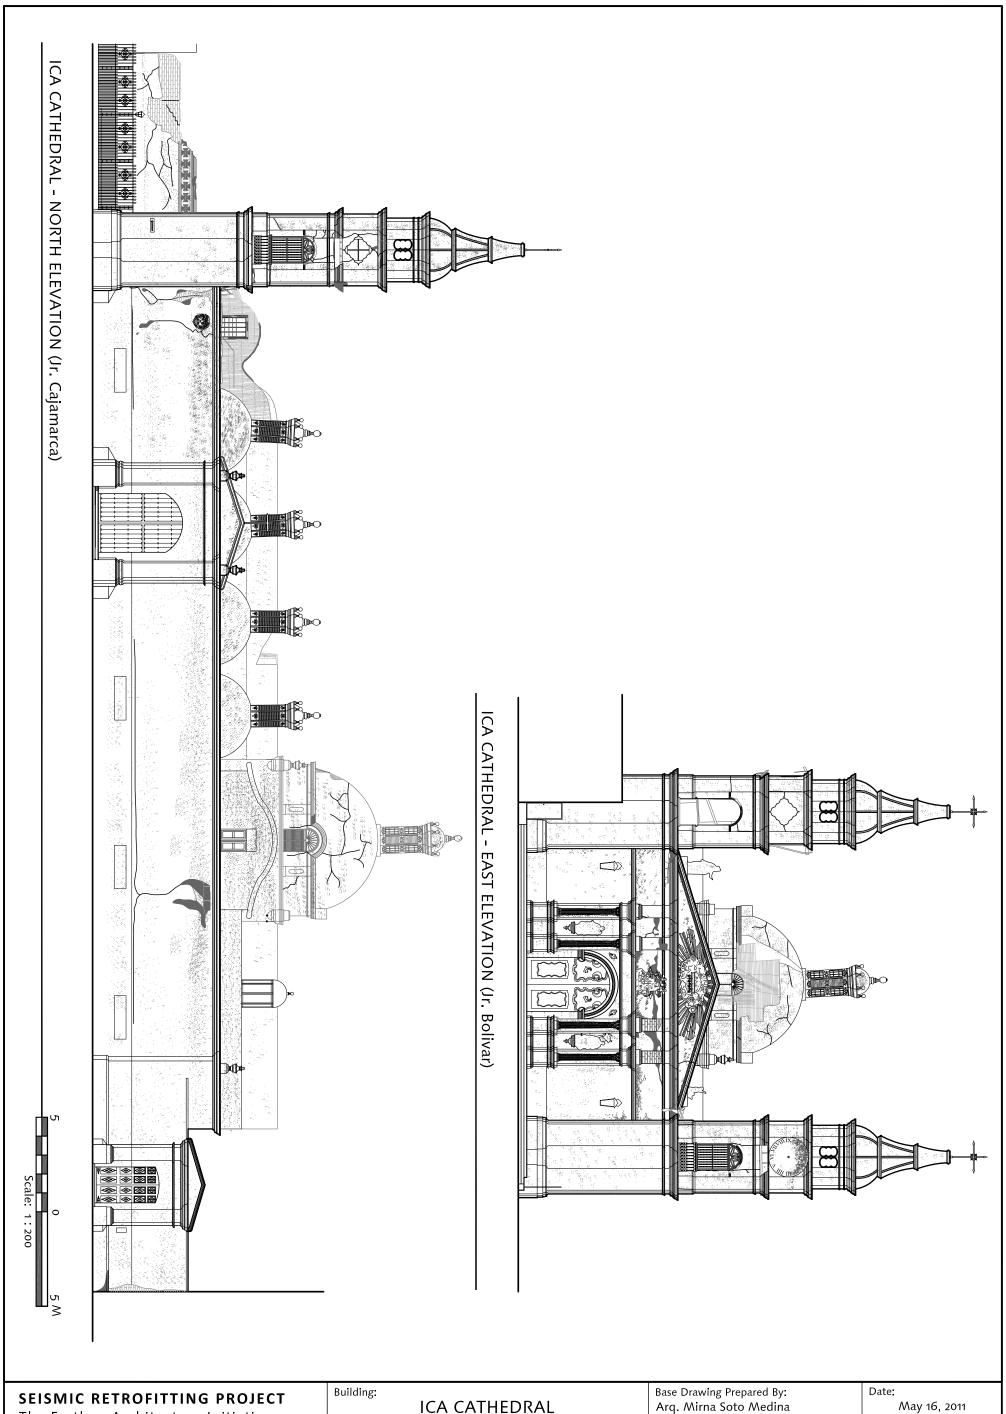

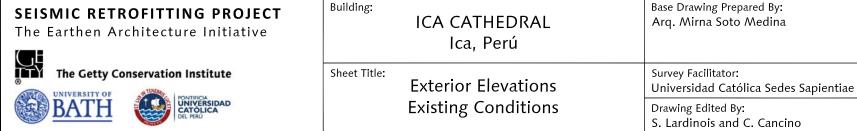


Scale:


Sheet No.:


1:200


IC-4

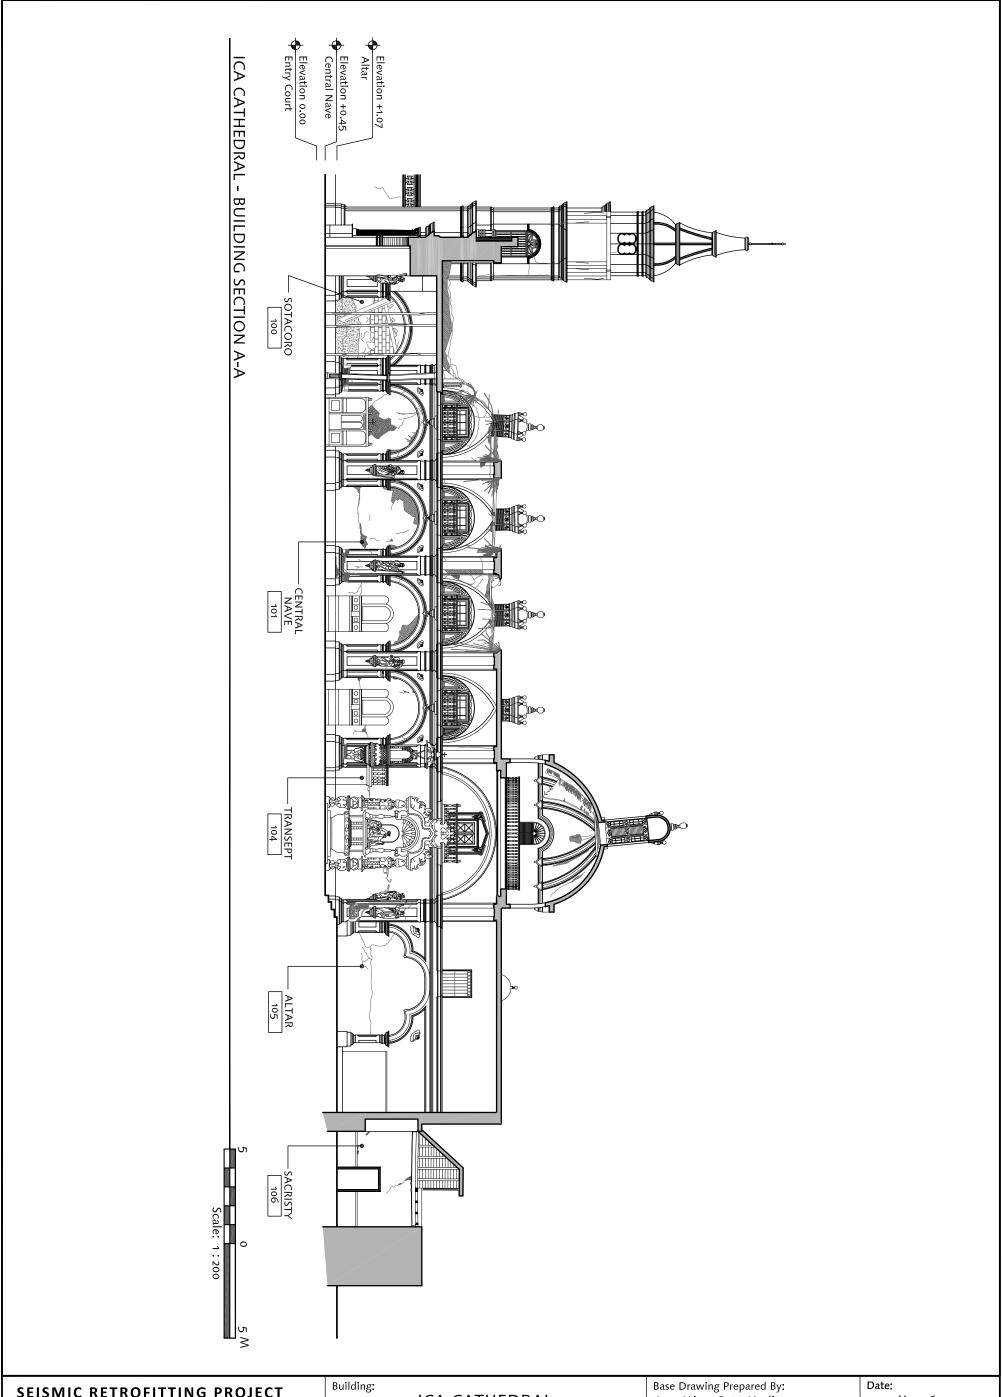



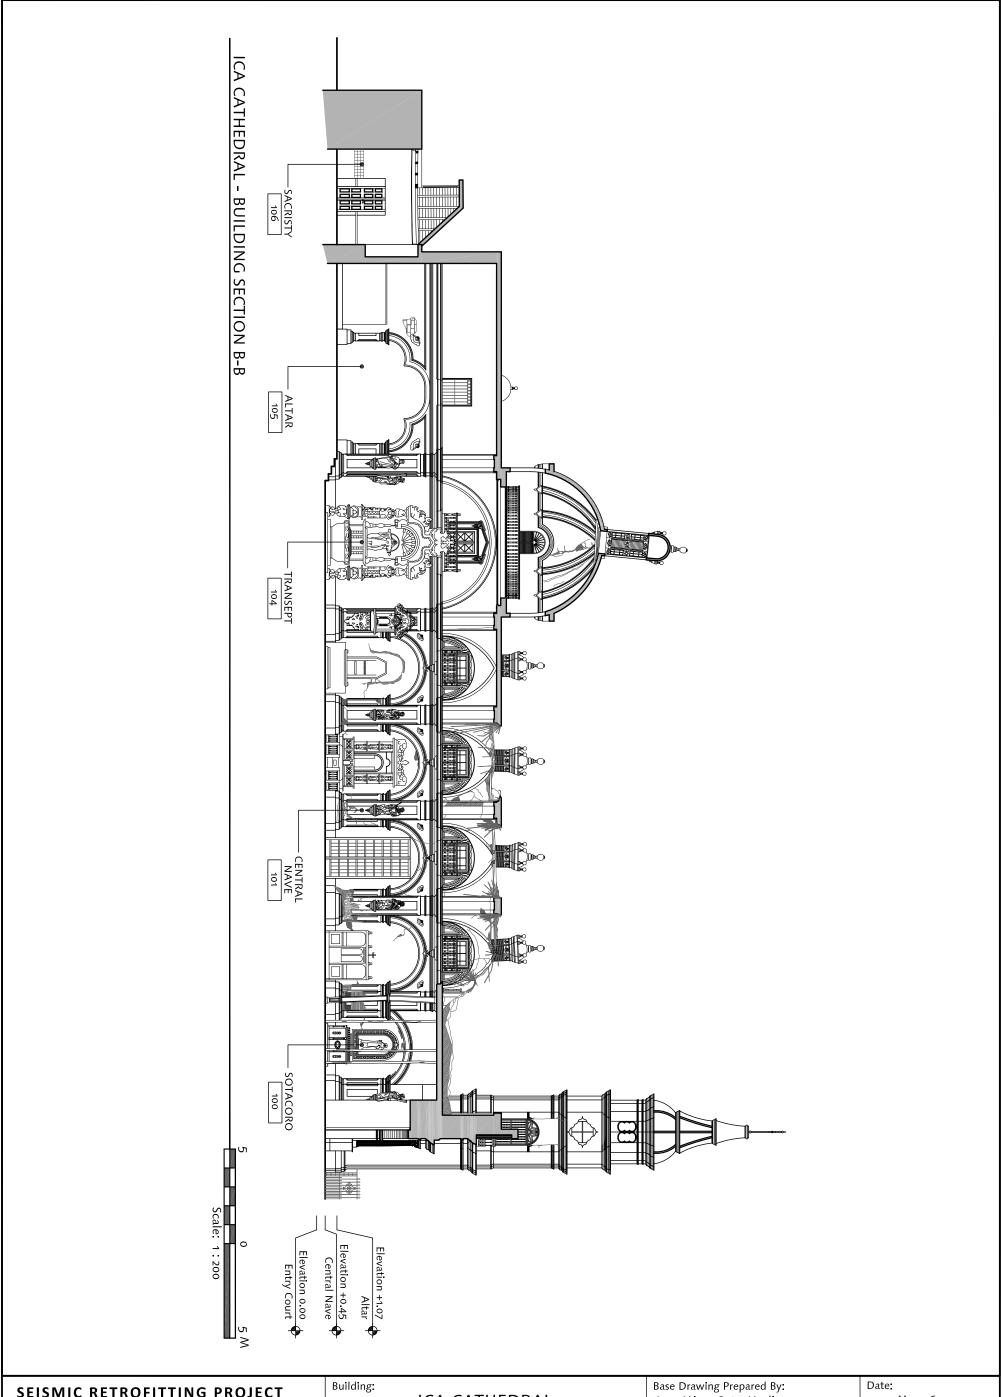

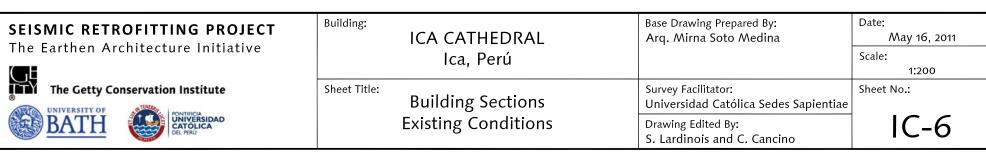


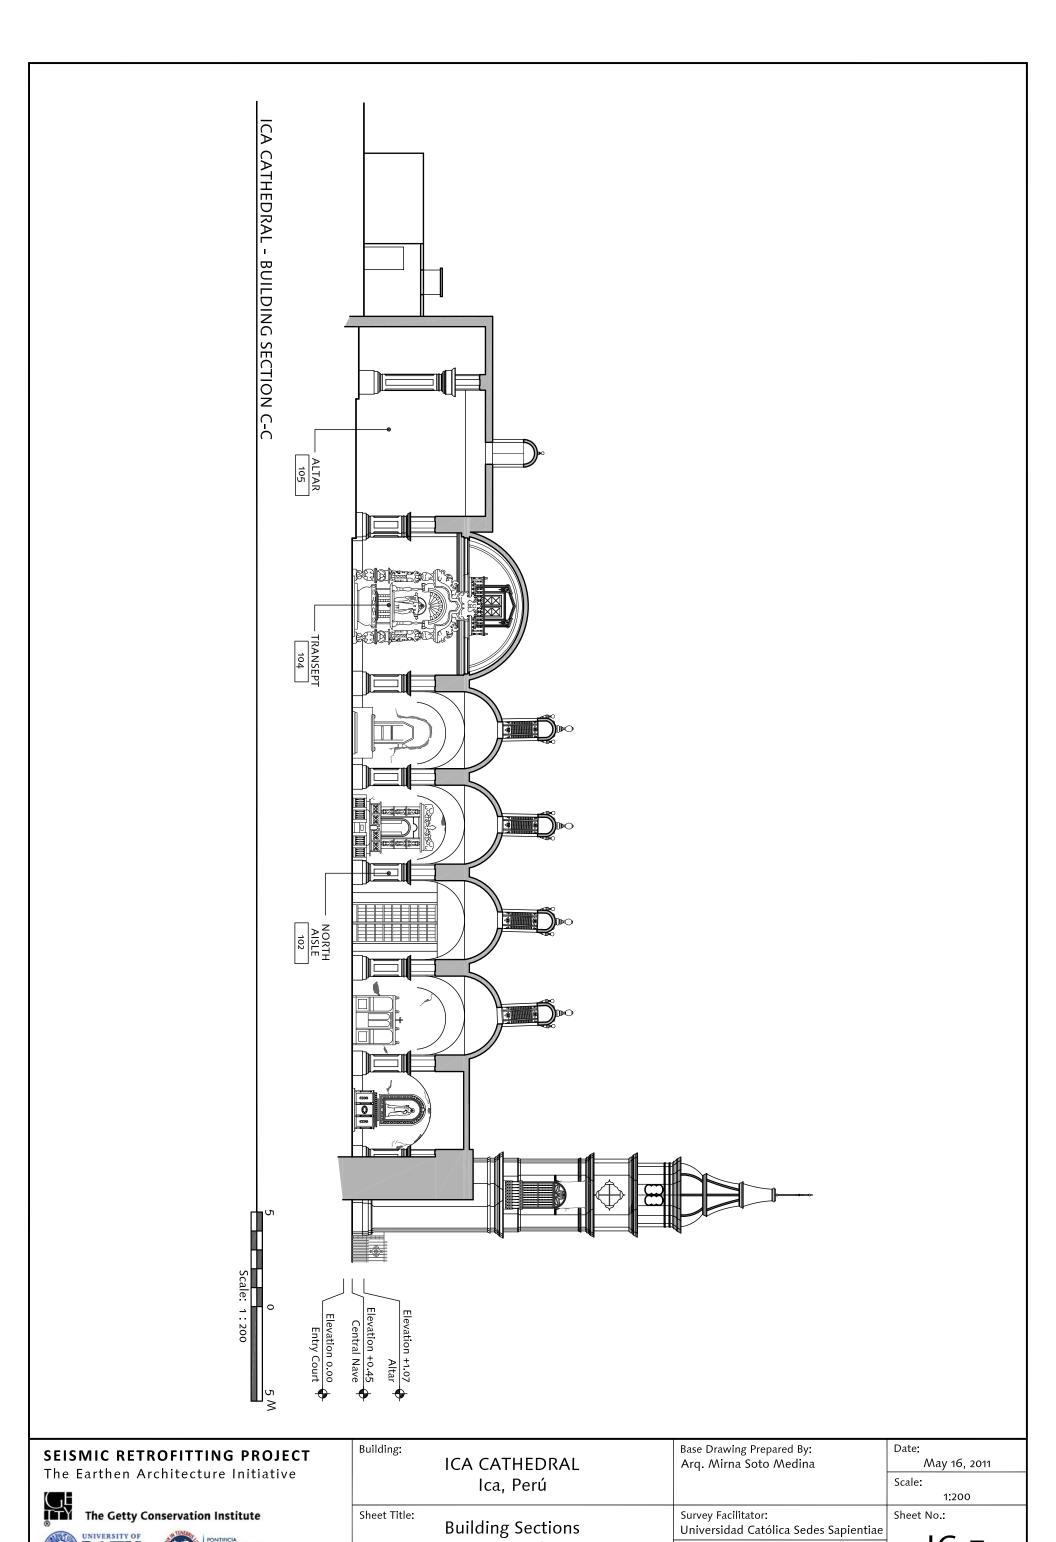


Drawing Edited By:


S. Lardinois and C. Cancino


IC-7

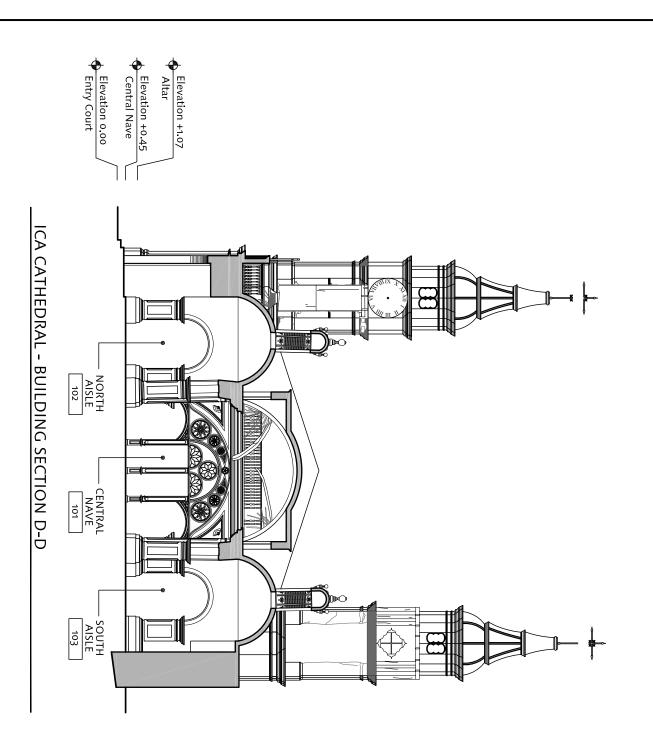


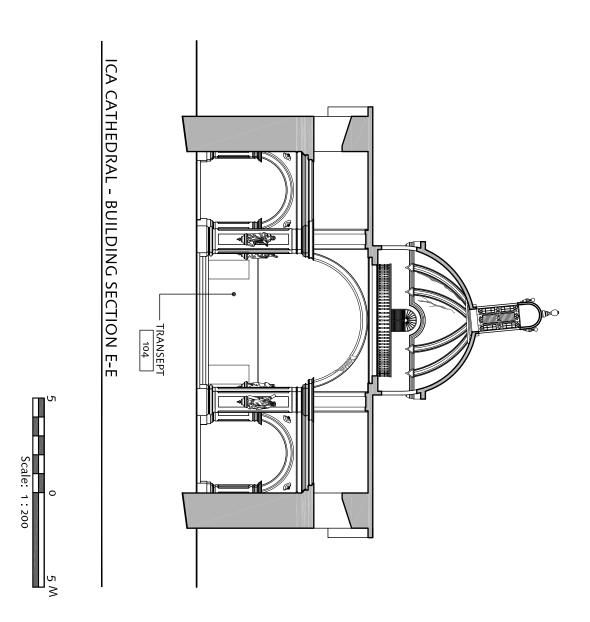



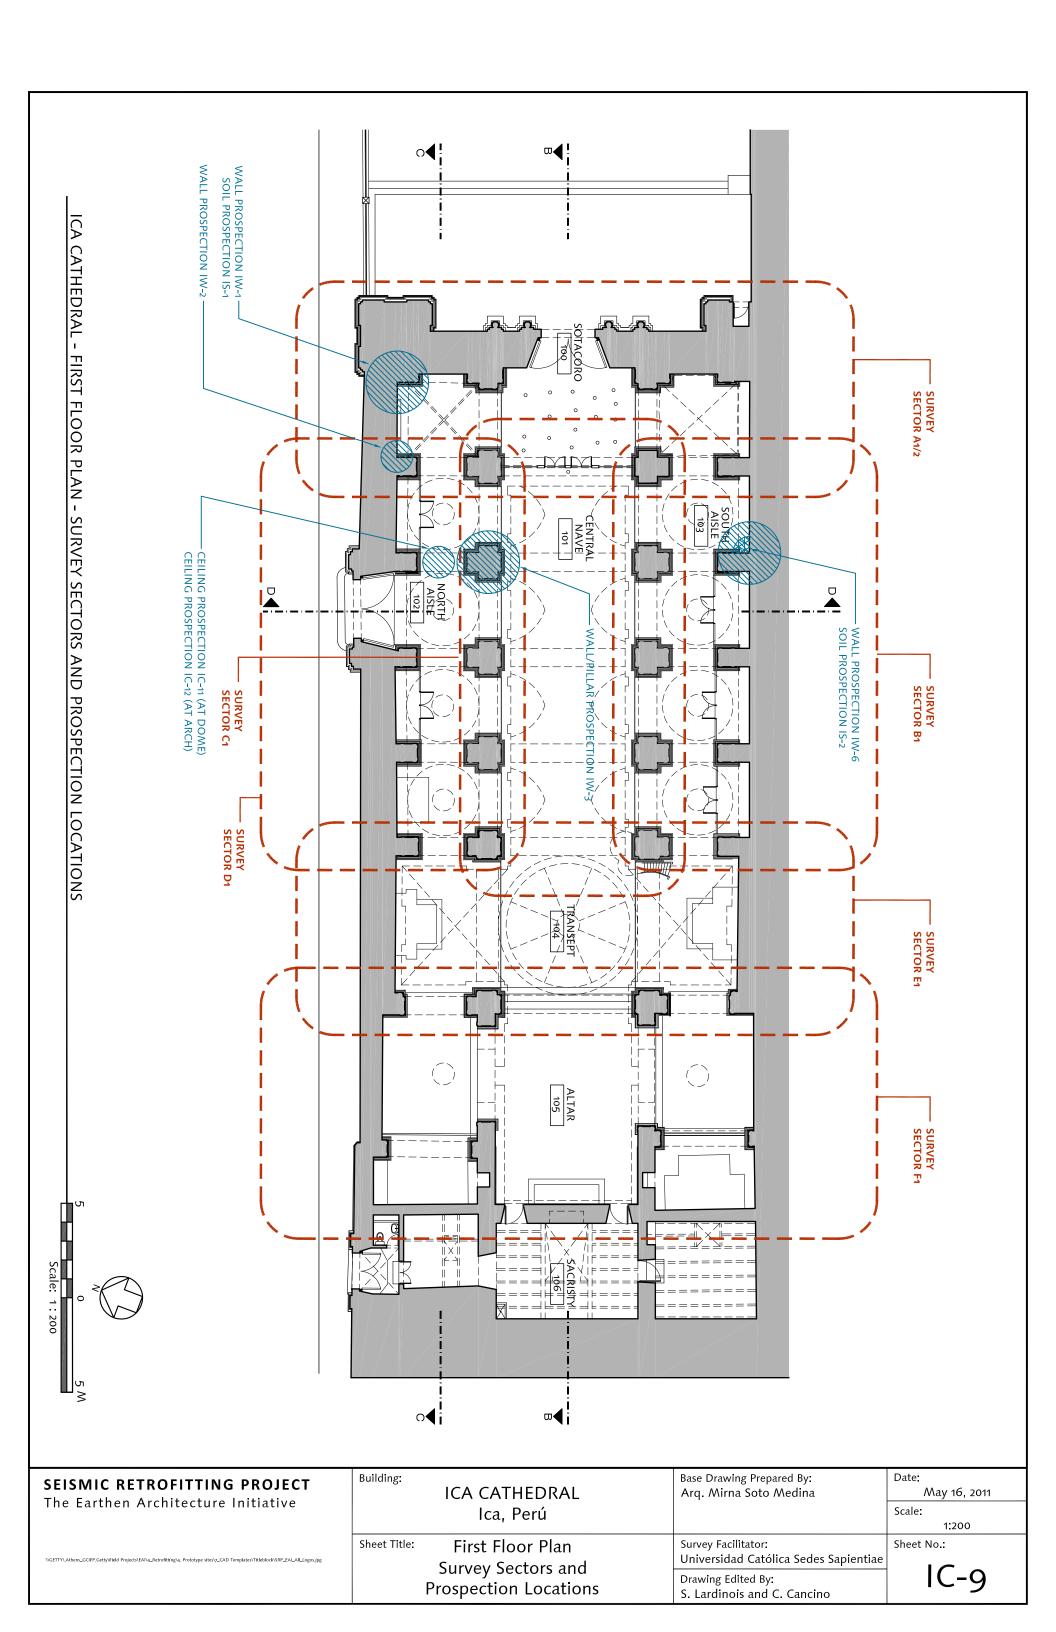

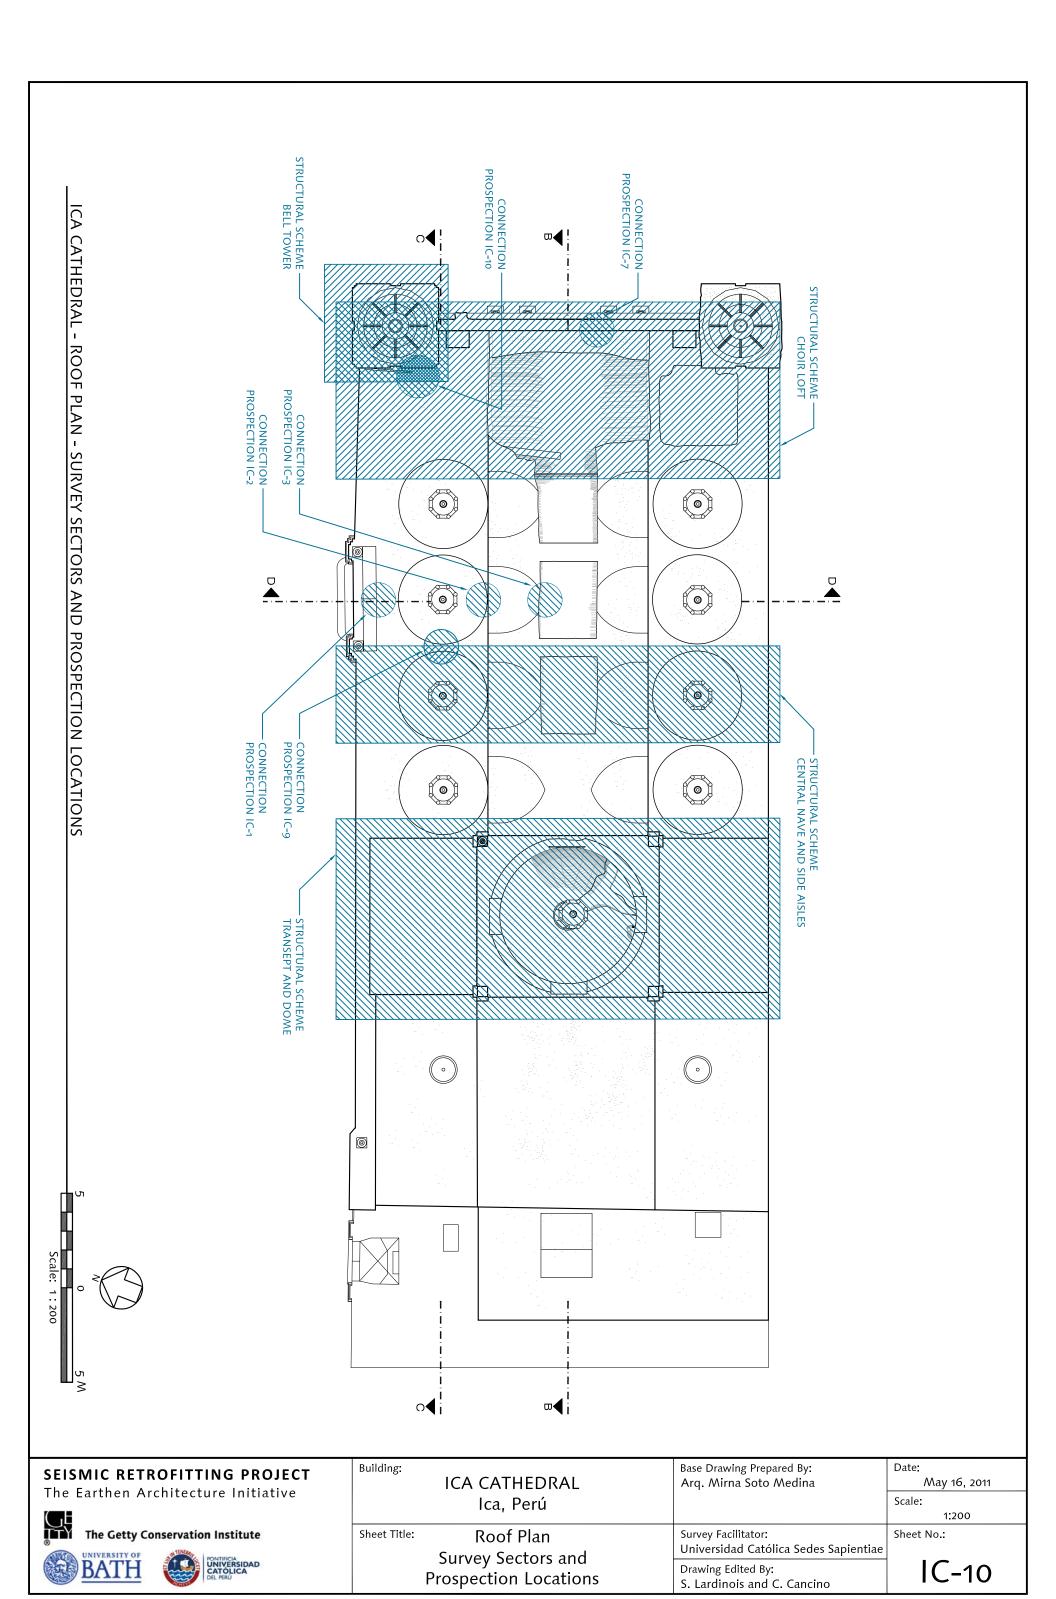


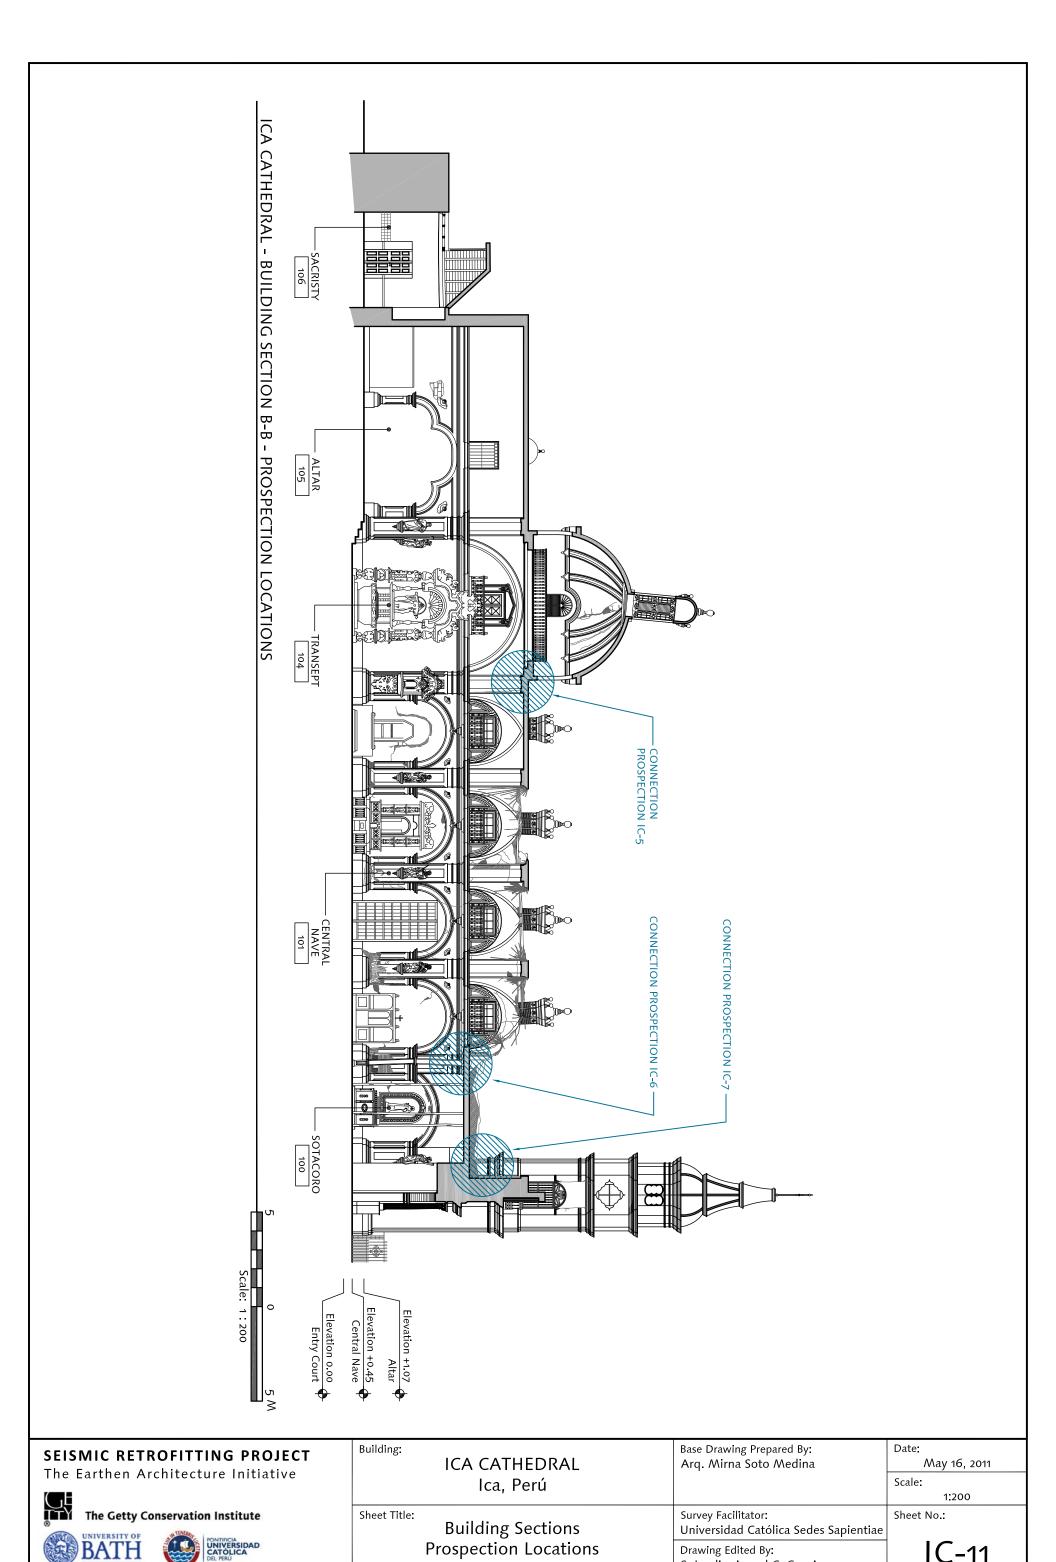



IC-11

Drawing Edited By:


S. Lardinois and C. Cancino

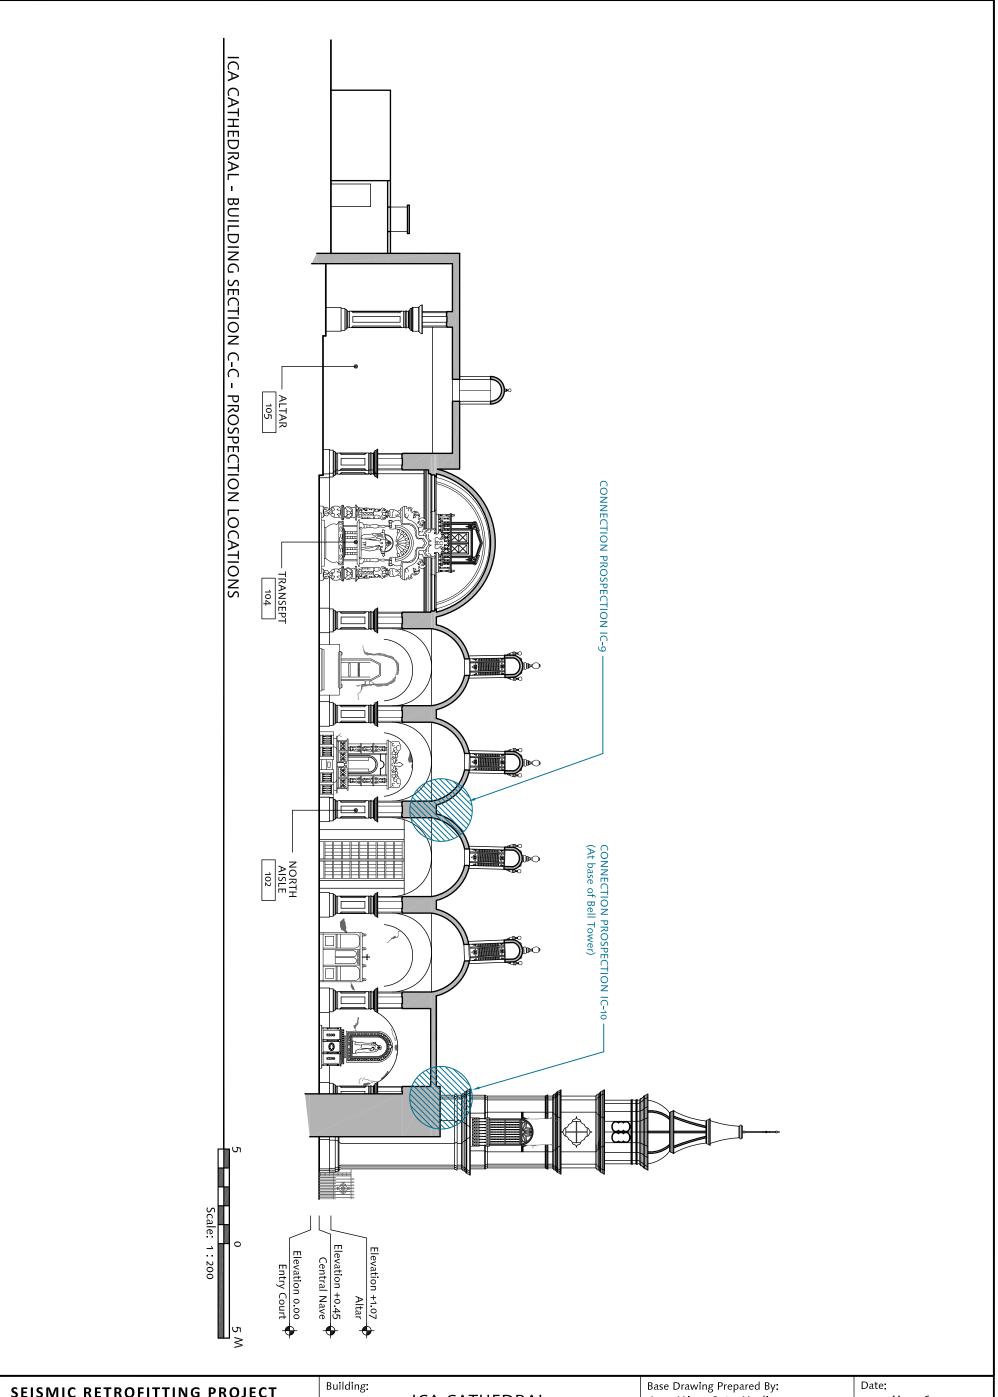


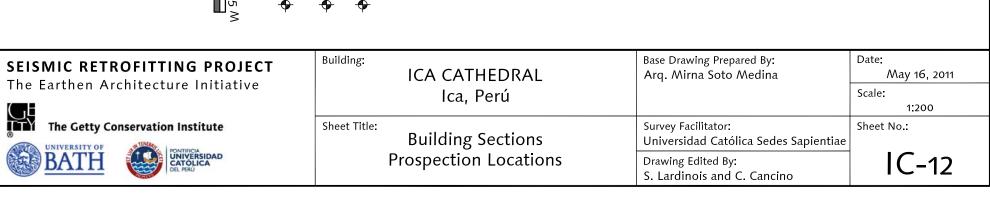

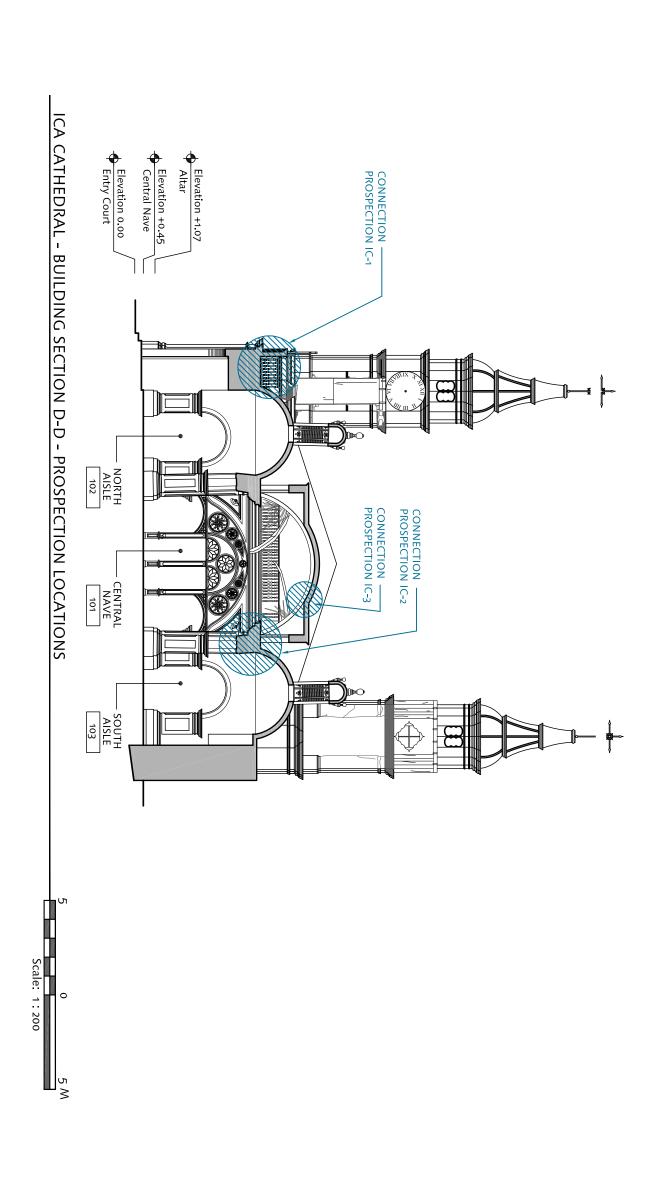



SEISMIC RETROFITTING PROJECT The Earthen Architecture Initiative	Building: ICA CATHEDRAL Ica, Perú	Base Drawing Prepared By: Arq. Mirna Soto Medina	Date: May 16, 2011 Scale: 1:200
The Getty Conservation Institute  UNIVERSITY OF PONTIFICIAL CATOLICA DEL PERU CATOLICA DEL PERU CATOLICA DEL PERU CATOLICA	Building Sections Prospection Locations	Survey Facilitator: Universidad Católica Sedes Sapientiae Drawing Edited By: S. Lardinois and C. Cancino	Sheet No.:

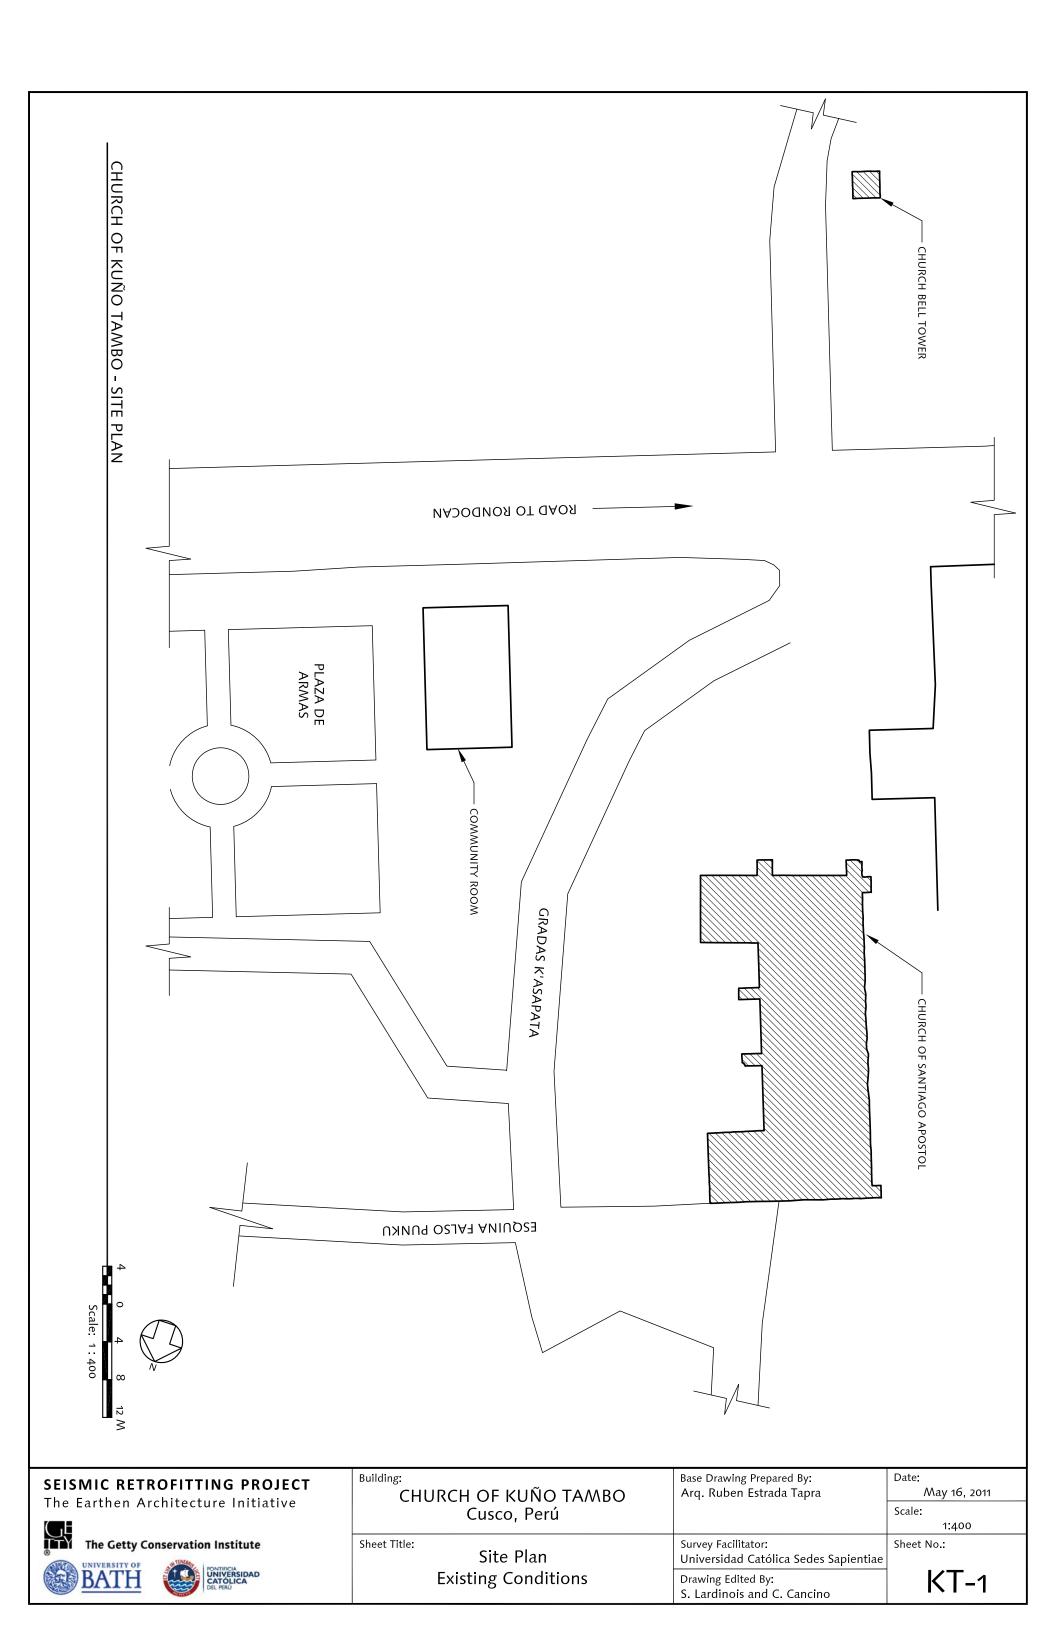

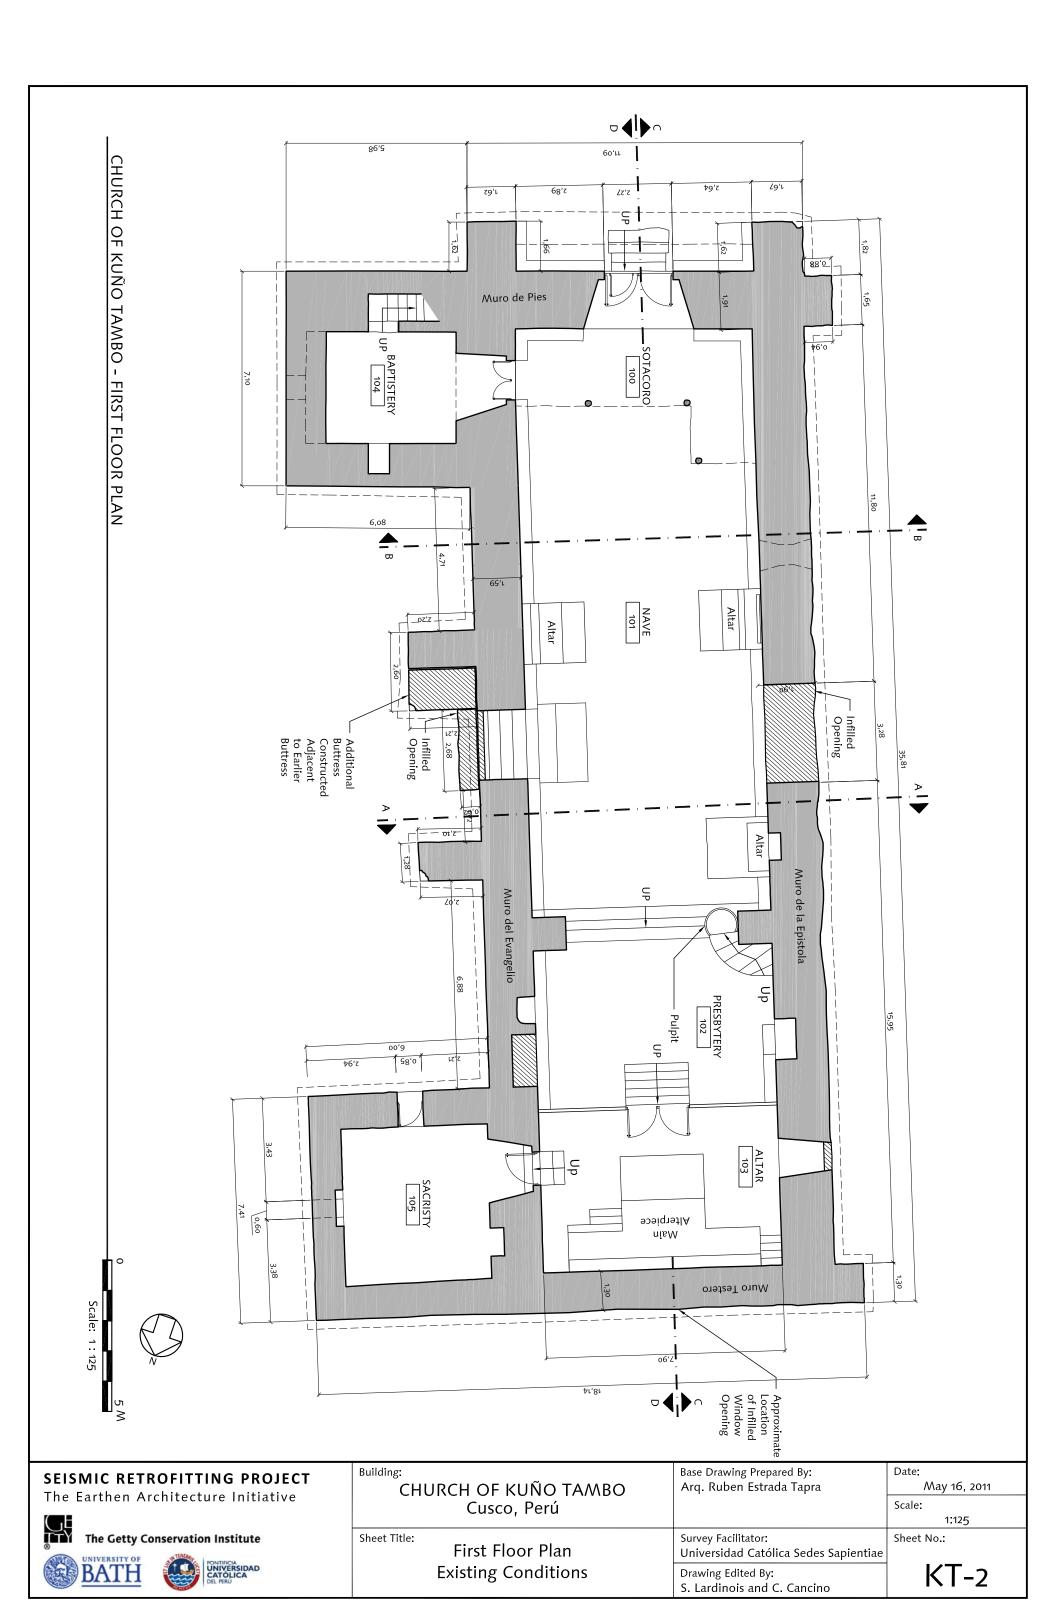


CHURCH OF KUÑO TAMBO - CHOIR LOFT PLAN

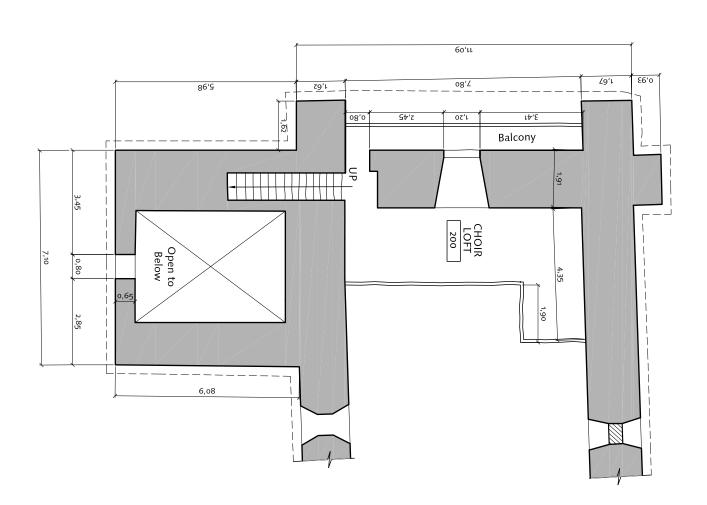

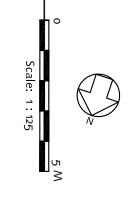

SEISMIC RETROFITTING PROJECT				
The Earthen Architecture Initiative				
The Getty Conservation Institute				
BATH WINVERSIDAD CATOLICA CATOLICA				

Building:	Base Drawing Prepared By:	Date:
CHURCH OF KUÑO TAMBO	Arq. Ruben Estrada Tapra	May 16, 2011
Cusco, Perú		Scale:
		1:125
Sheet Title:	Survey Facilitator:	Sheet No.:
Choir Loft Plan	Universidad Católica Sedes Sapientiae	I / <del>-</del>
Existing Conditions	Drawing Edited By:	KI-3
O .	S. Lardinois and C. Cancino	

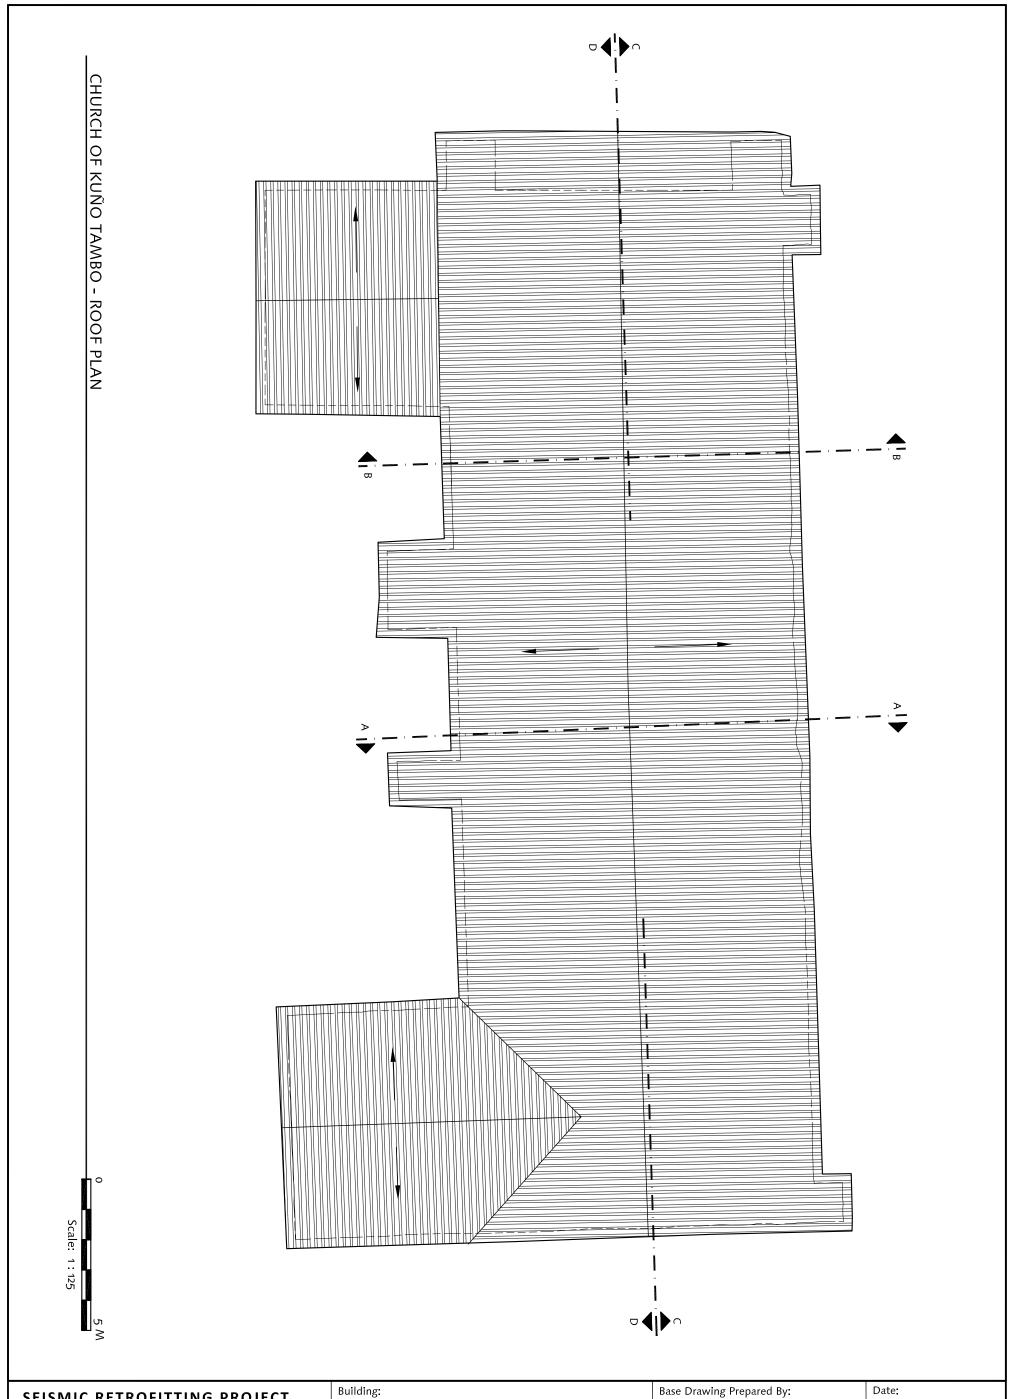



CHURCH OF KUÑO TAMBO Cusco, Perú Base Drawing Prepared By: Arq. Ruben Estrada Tapra

May 16, 2011

Scale:
1:125

Sheet Title:

Roof Plan
Existing Conditions

Survey Facilitator:
Universidad Católica Sedes Sapientiae


Drawing Edited By:
S. Lardinois and C. Cancino

KT-4





Drawing Edited By:


S. Lardinois and C. Cancino

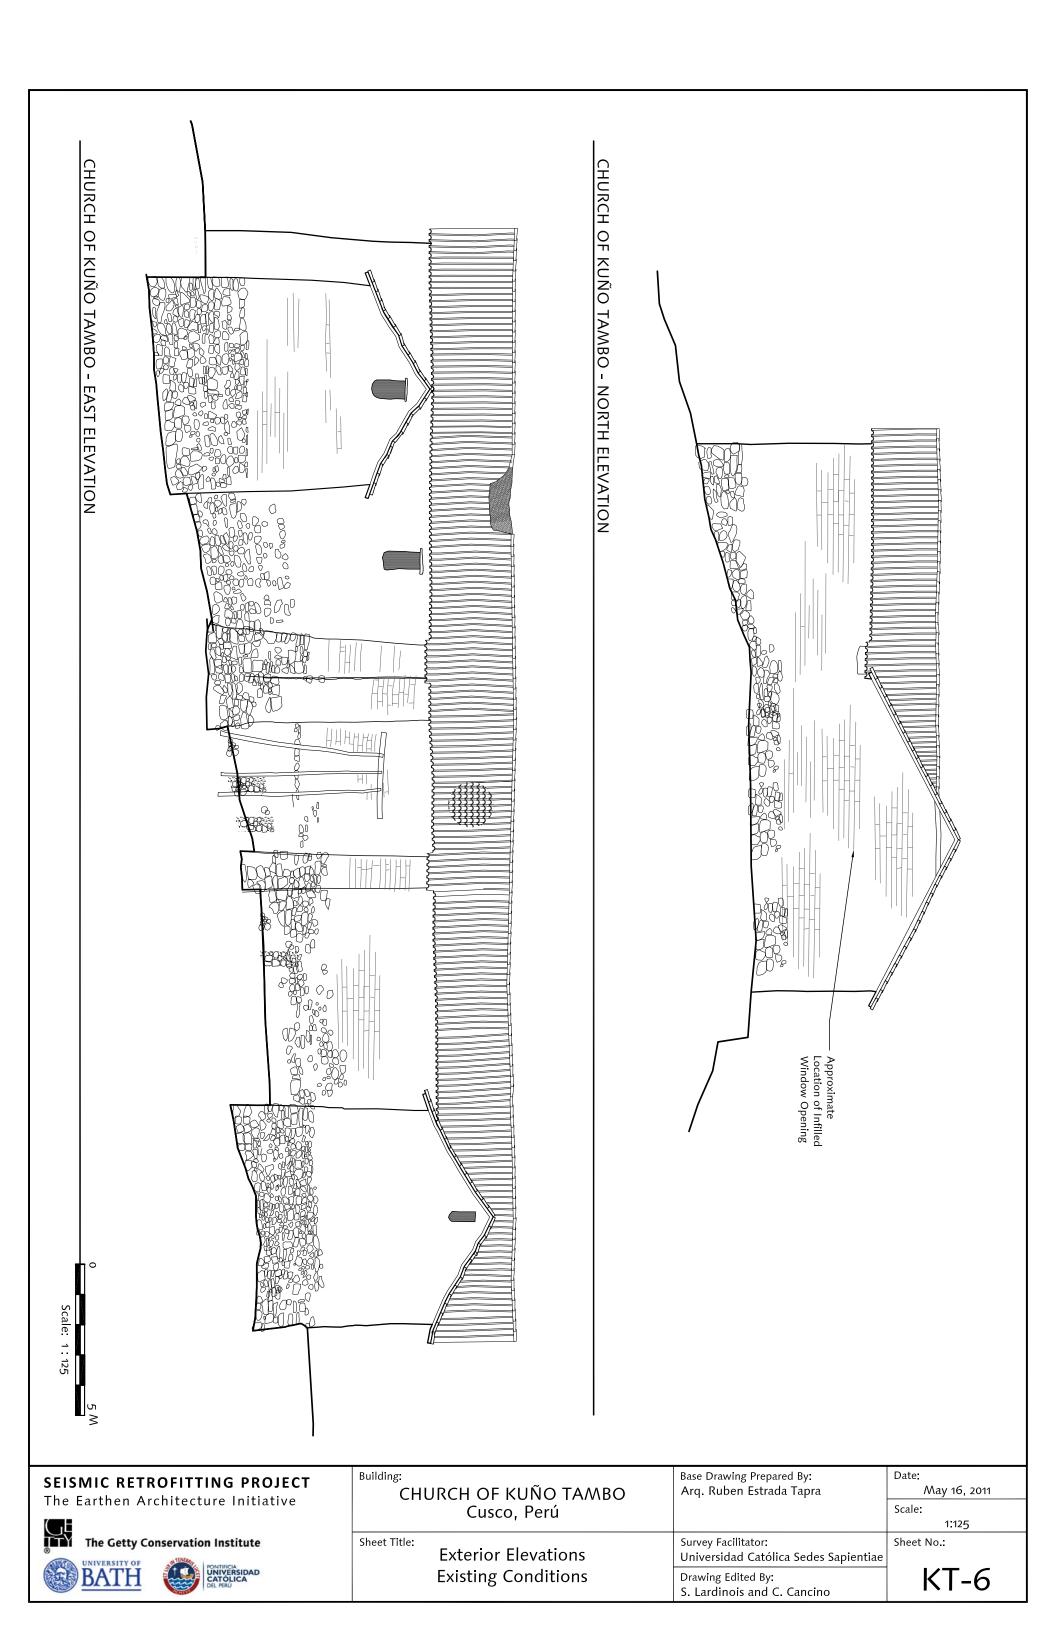




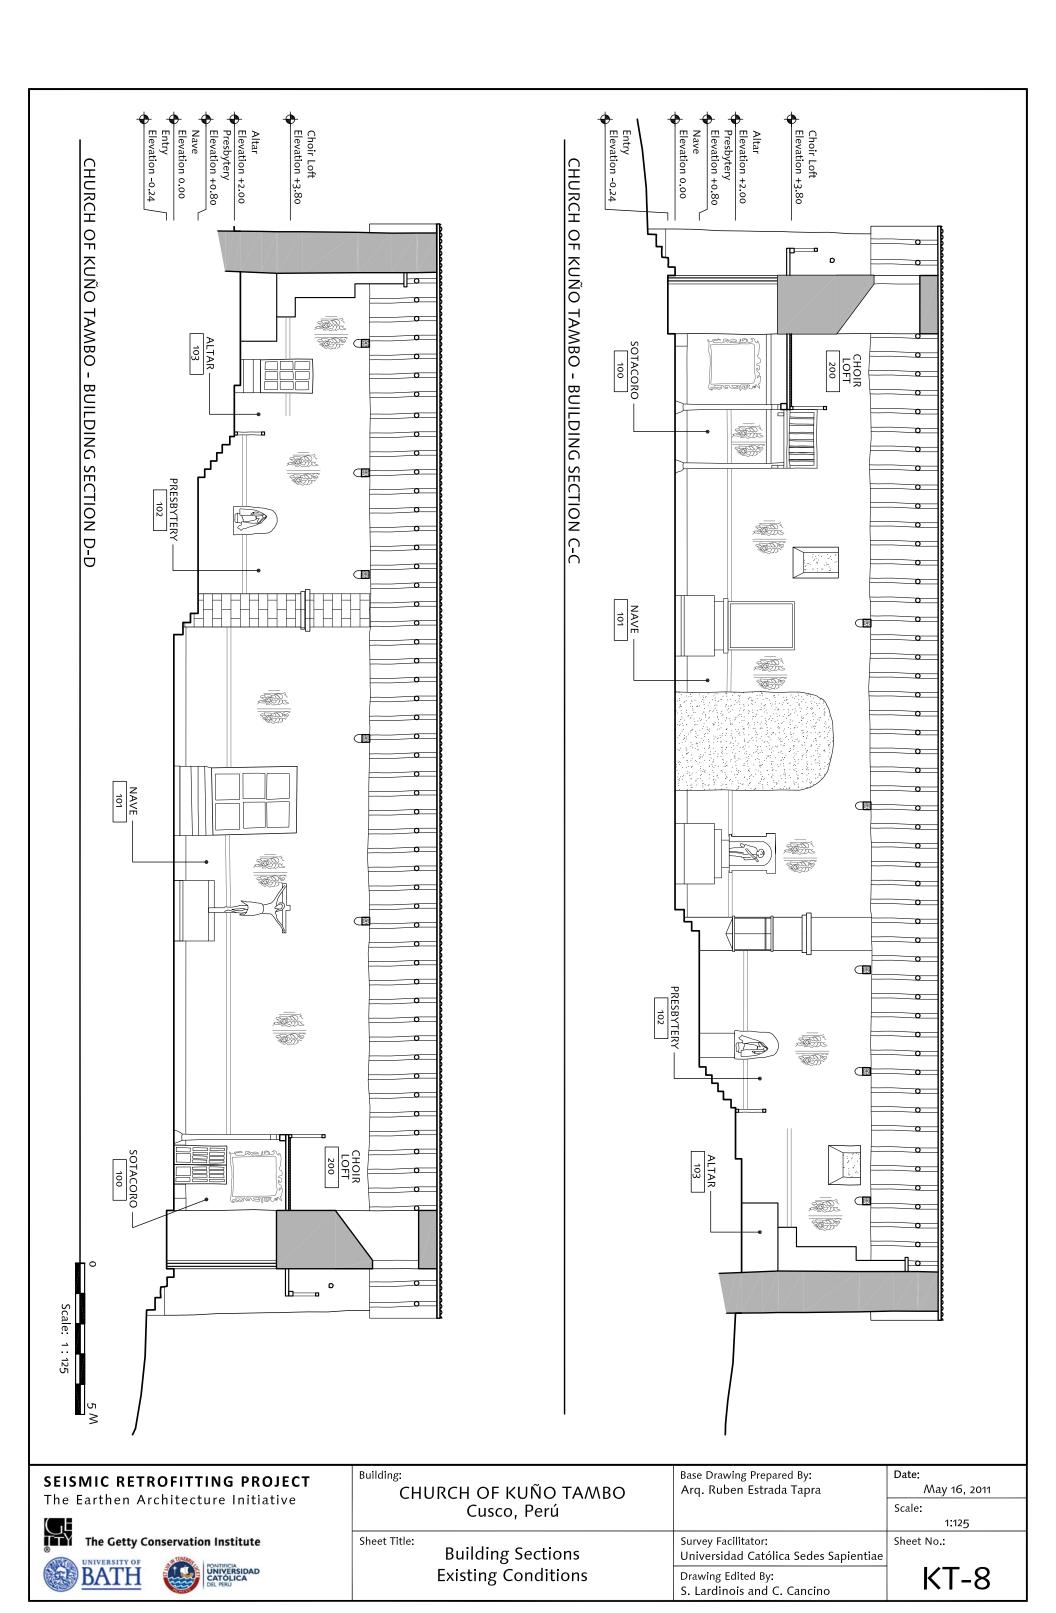

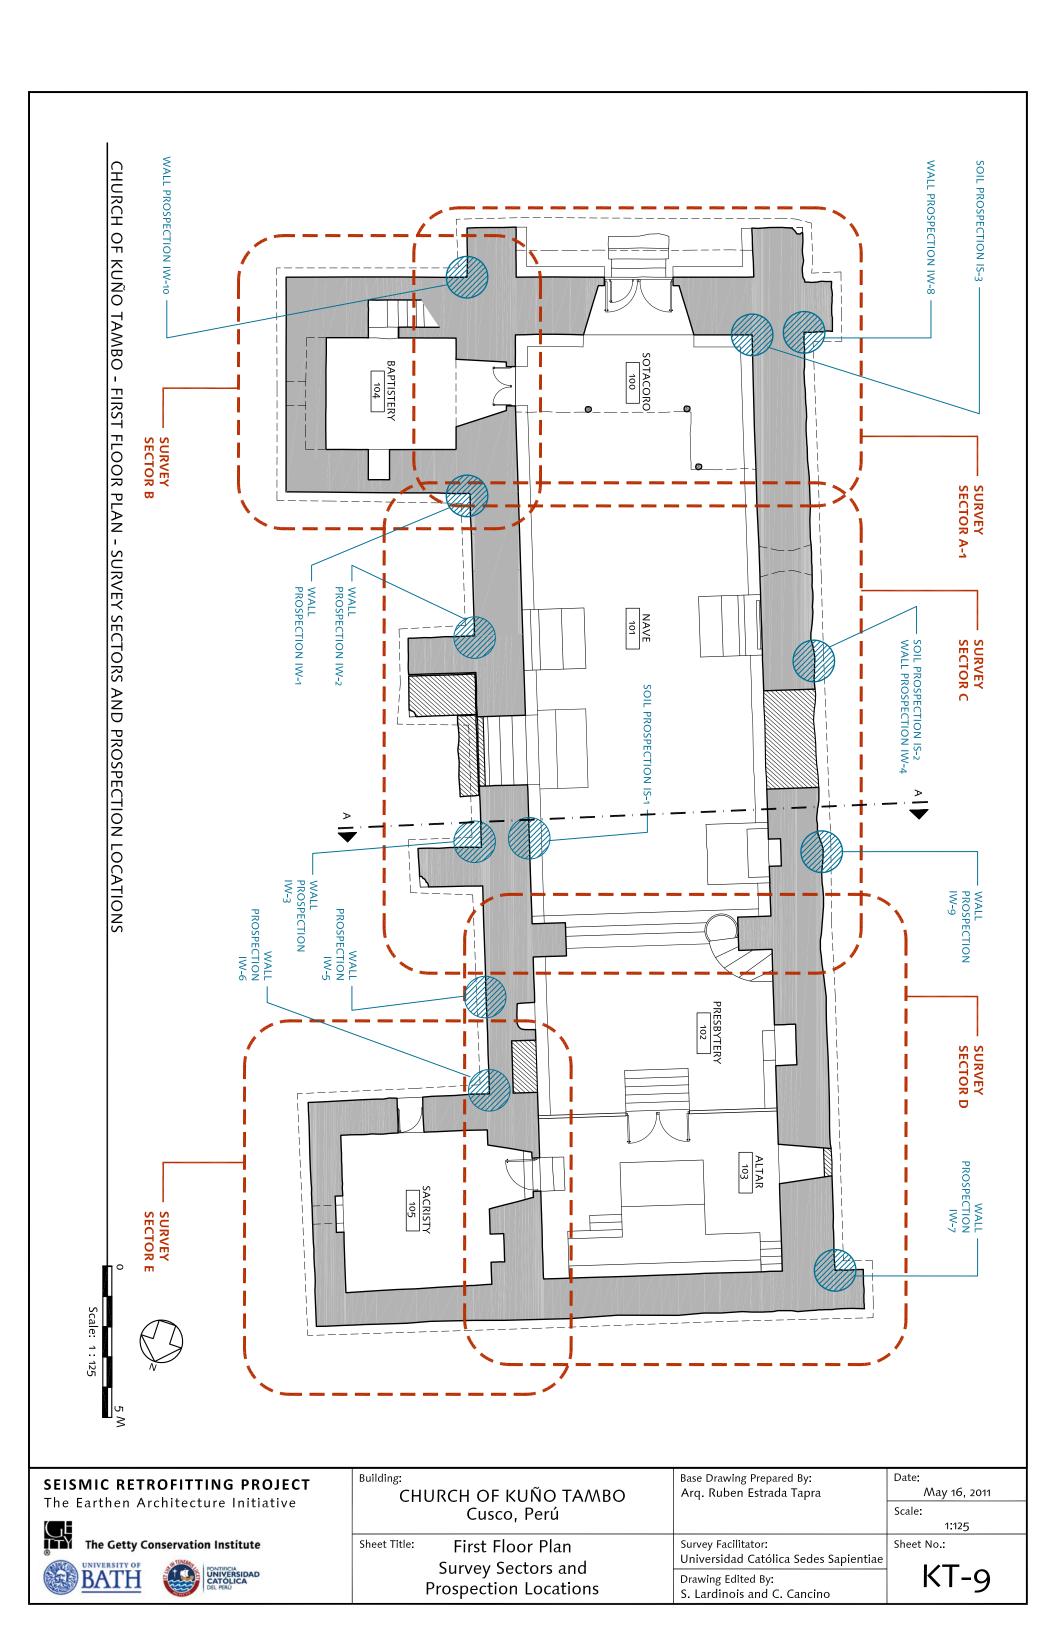

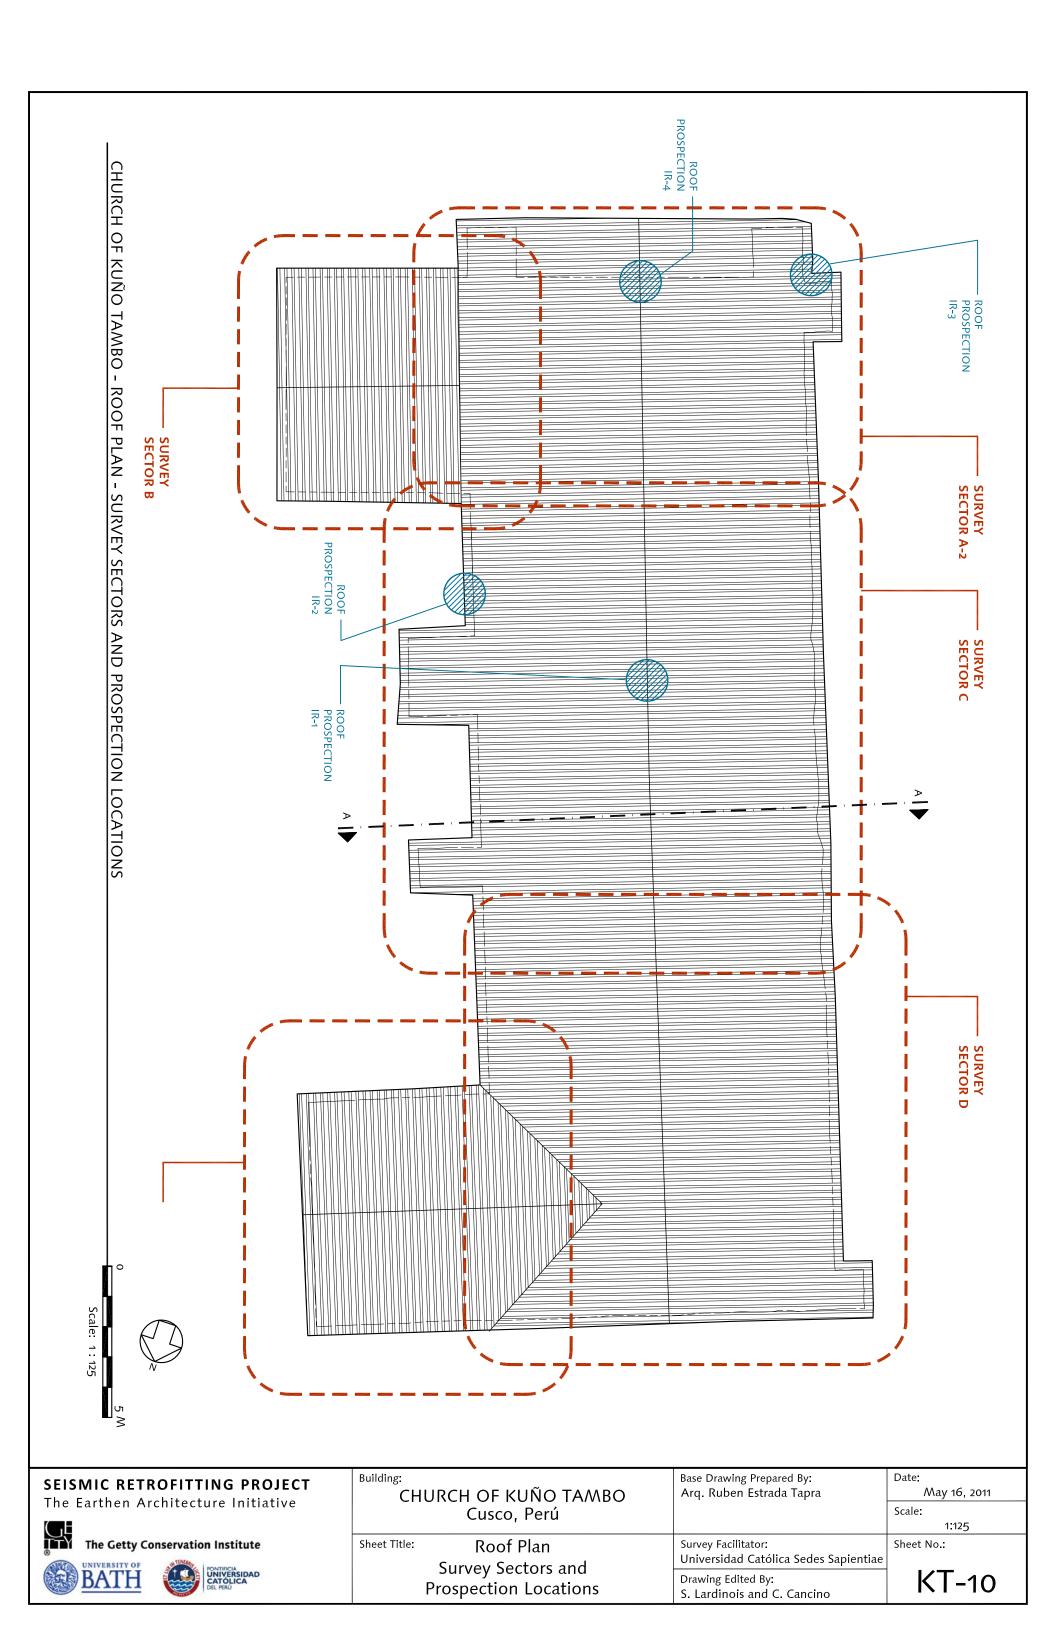

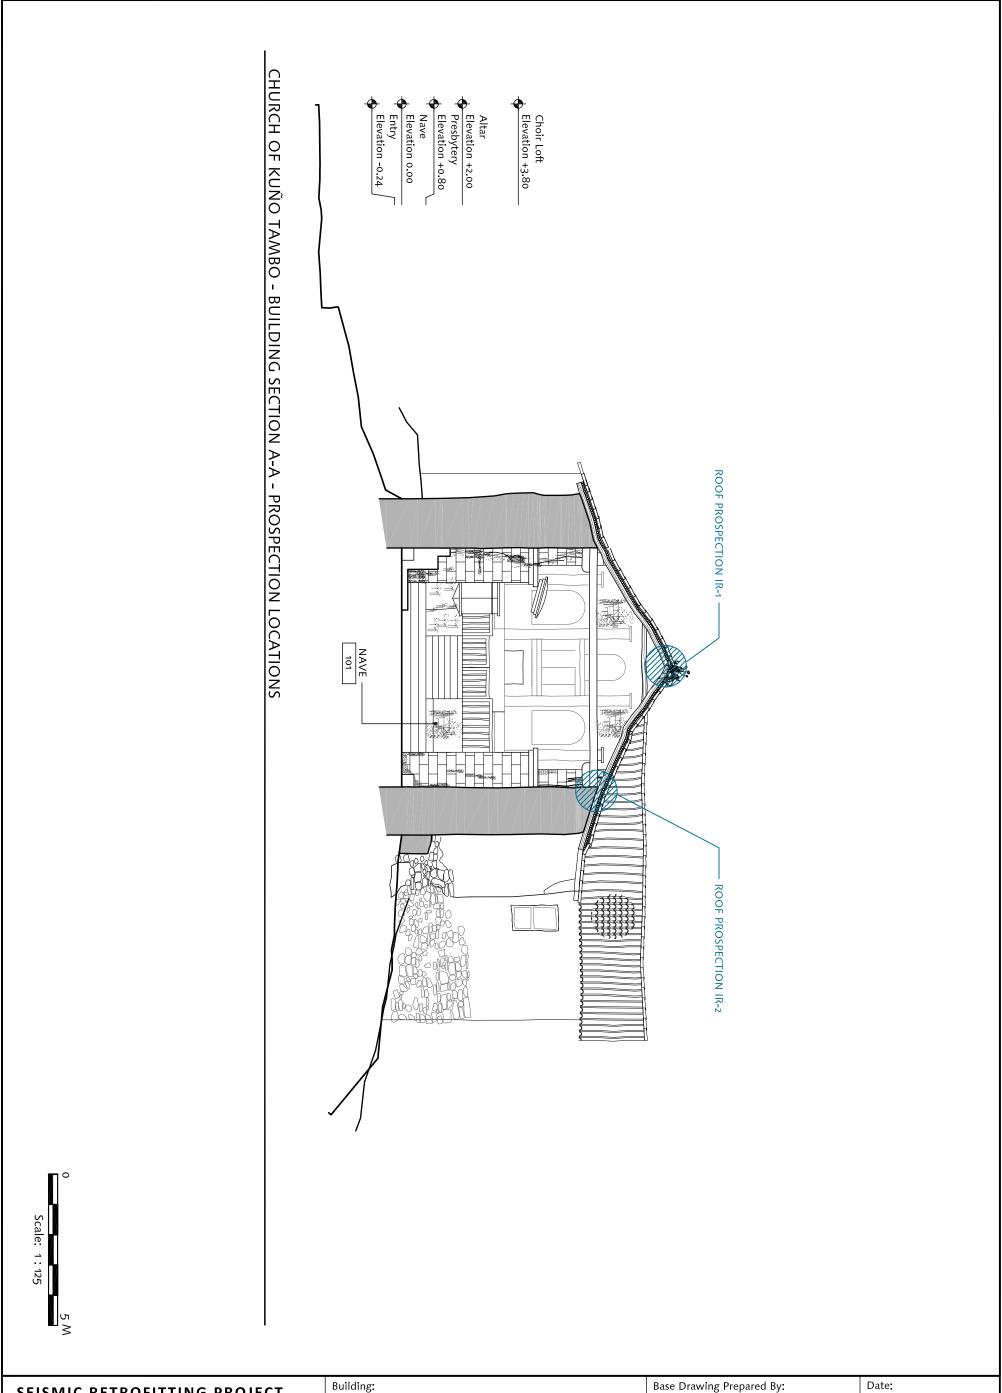



CHURCH OF KUÑO TAMBO Cusco, Perú

Base Drawing Prepared By:
Arq. Ruben Estrada Tapra


May 16, 2011

Scale: 1:125 Sheet No.:


Sheet Title: Building Sections Prospction Locations


Survey Facilitator: Universidad Católica Sedes Sapientiae Drawing Edited By: S. Lardinois and C. Cancino


KT-11

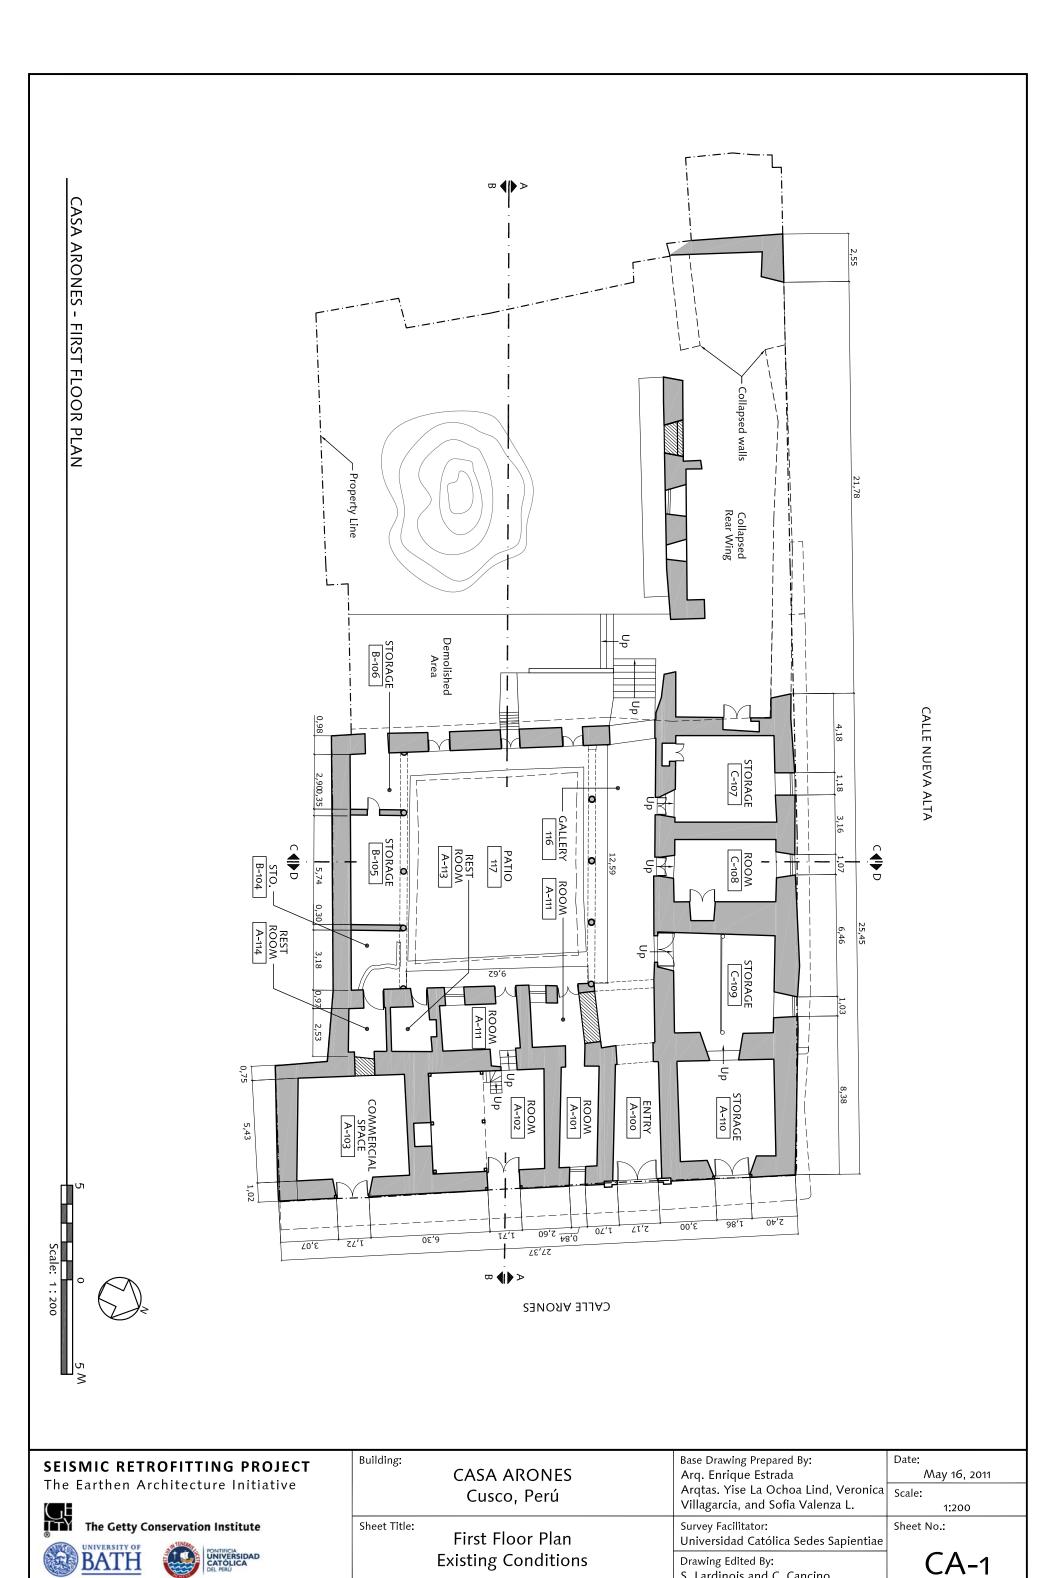


S. Lardinois and C. Cancino

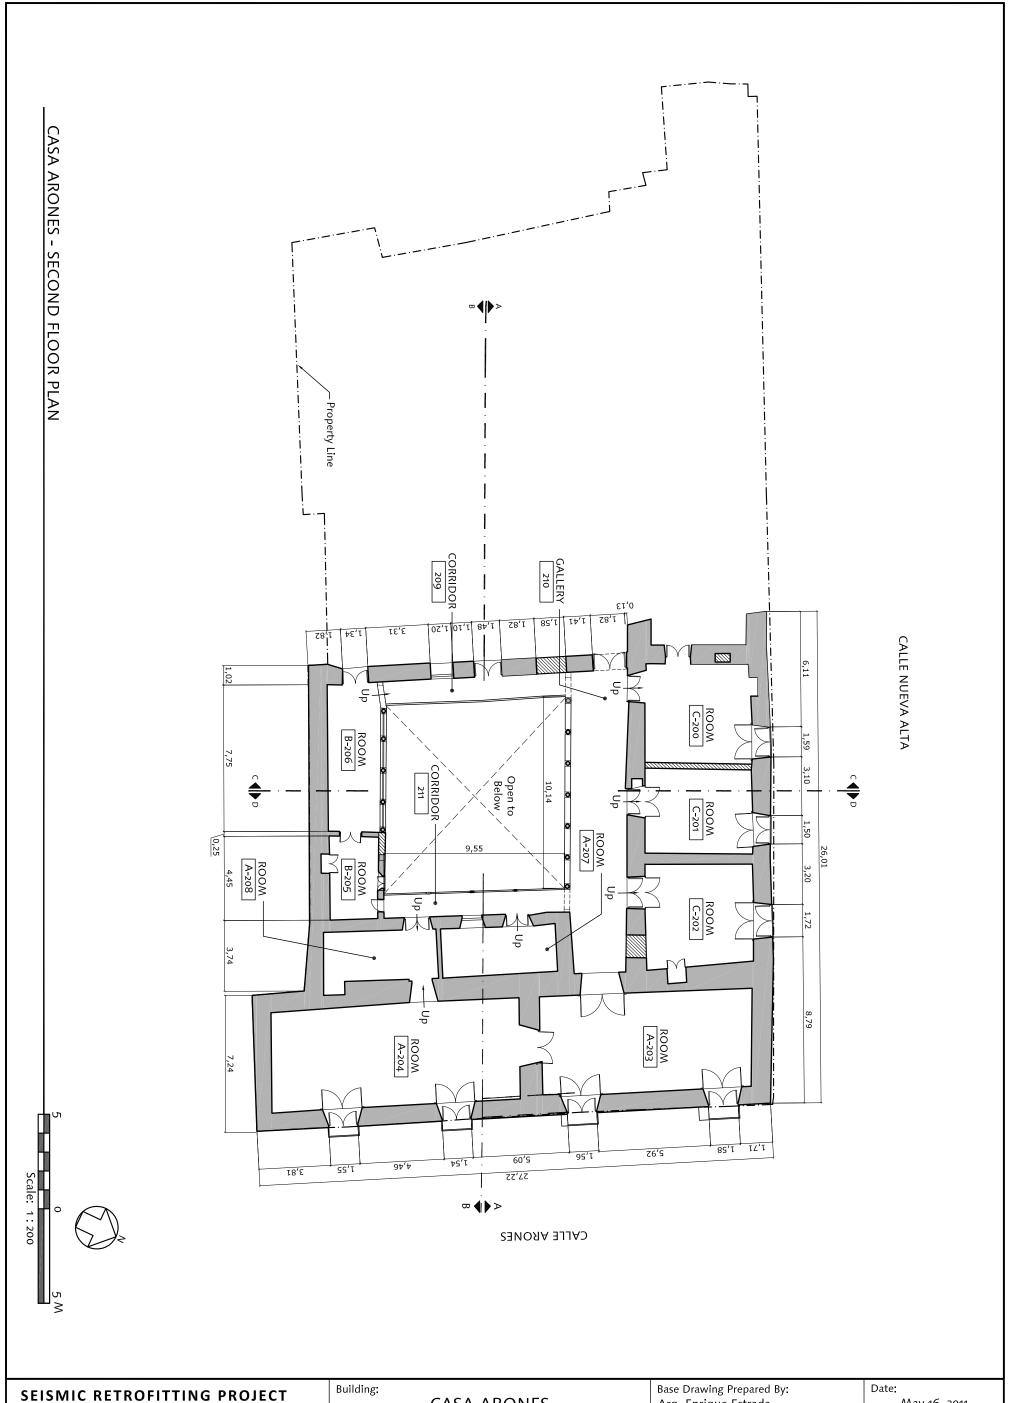

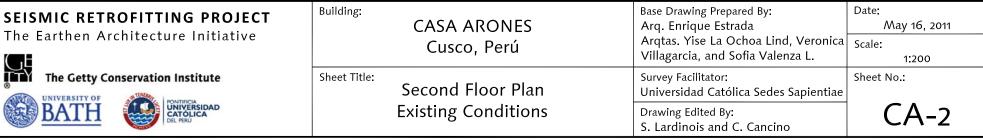


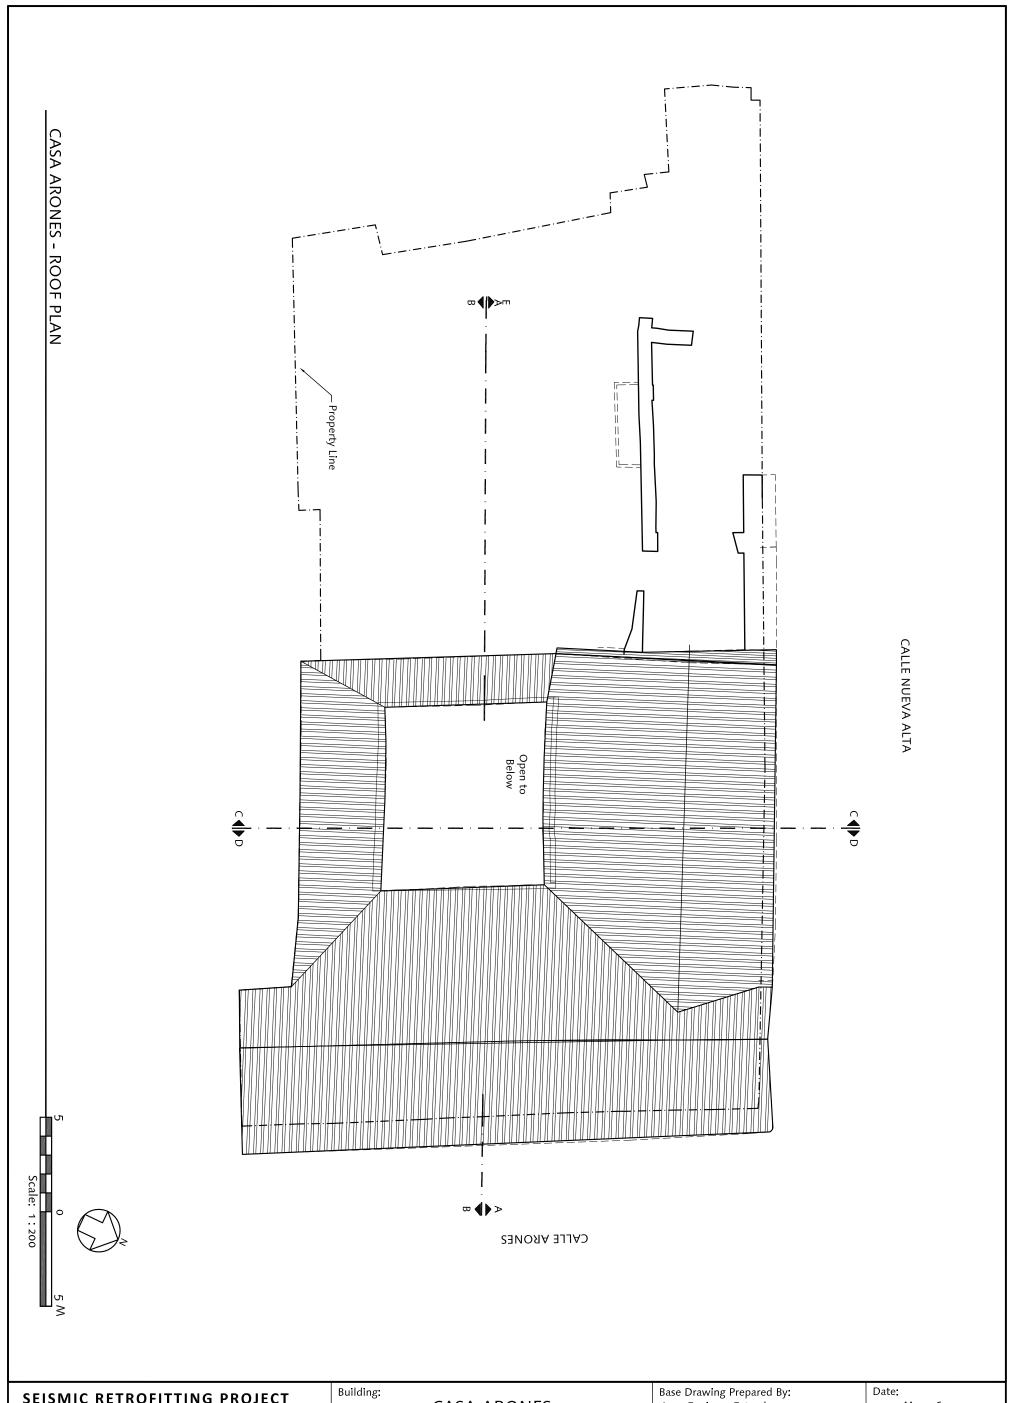


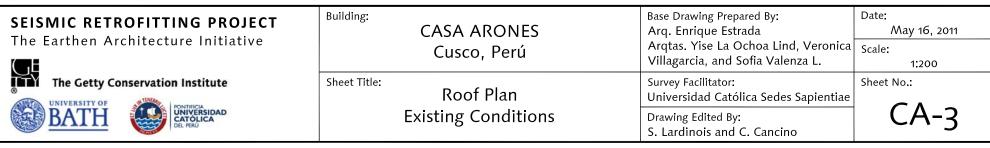



CASA ARONES - NORTHWEST ELEVATION (CALLE NUEVA ALTA)

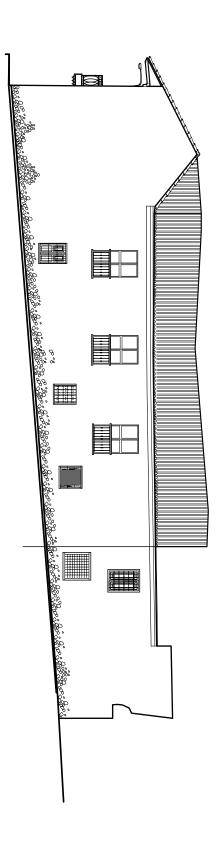

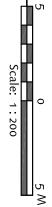

SEISMIC RETROFITTING PROJECT The Earthen Architecture Initiative





Building	
J	CASA ARONES
	Cusco, Perú


Sheet Title: **Exterior Elevations Existing Conditions** 


Base Drawing Prepared By:	Date:
Arq. Enrique Estrada	
Arqtas. Yise La Ochoa Lind, Veronica Villagarcia, and Sofia Valenza L.	Scale:
Survey Facilitator:	Sheet

Scale: 1:200 Sheet No.: CA-4

May 16, 2011

Perú Universidad Católica Sedes Sapientiae Drawing Edited By: S. Lardinois and C. Cancino

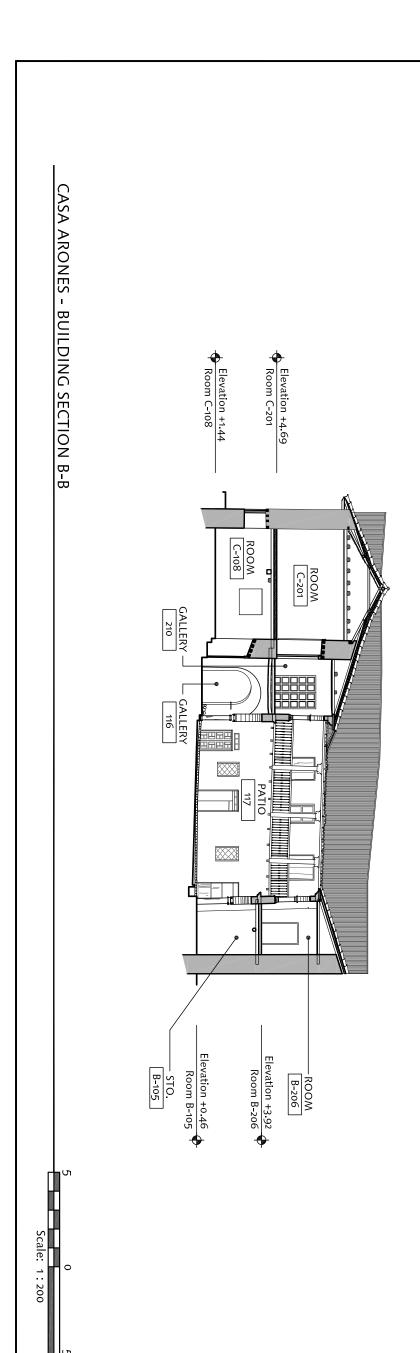

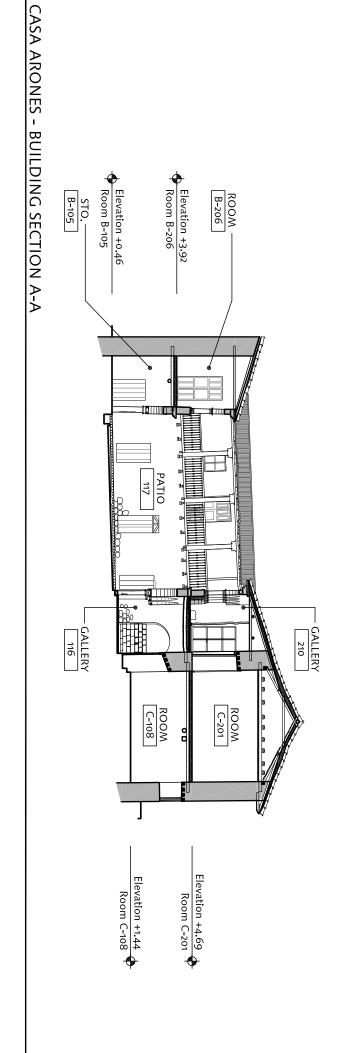

SEISMIC RETROFITTIN	G PROJECT
The Earthen Architecture	e Initiative
The Getty Conservation In BATH	ISTITUTE VERSIDAD OLICA

Building:	CASA ARONES Cusco, Perú
Sheet Title:	D IIII C II

Base Drawing Prepared By:
Arq. Enrique Estrada
Arqtas. Yise La Ochoa Lind, Veronica
Villagarcia, and Sofia Valenza L.

Survey Facilitator:
Universidad Católica Sedes Sapientiae
Drawing Edited By:

Date:


Scale:


Sheet


May 16, 2011
Scale:
1:200
Sheet No.:


Building Sections
Existing Conditions


Drawing Edited By:
S. Lardinois and C. Cancino

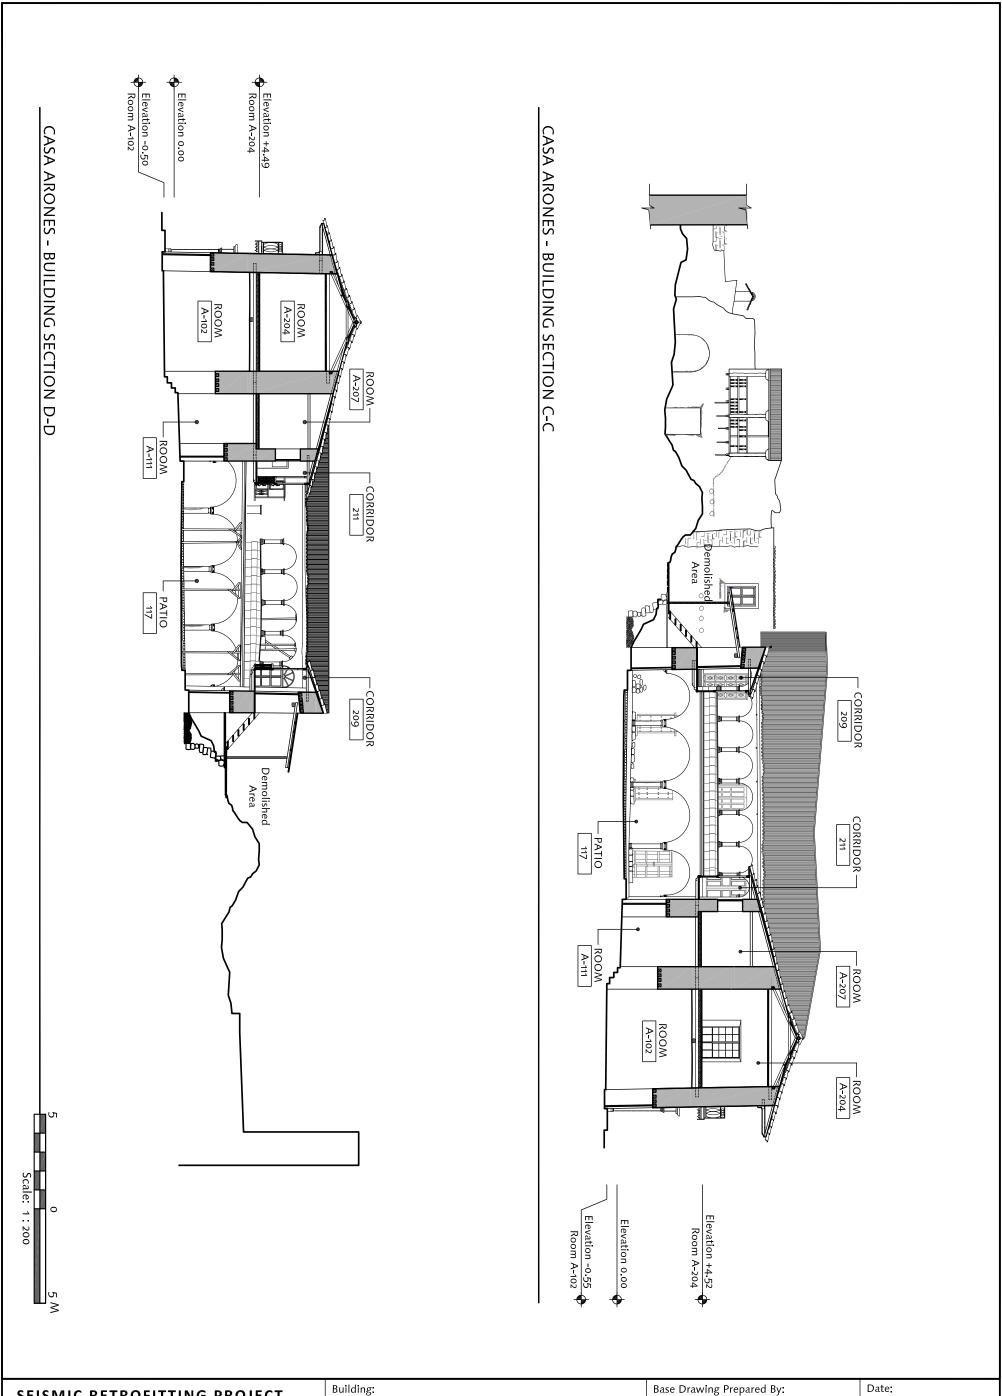


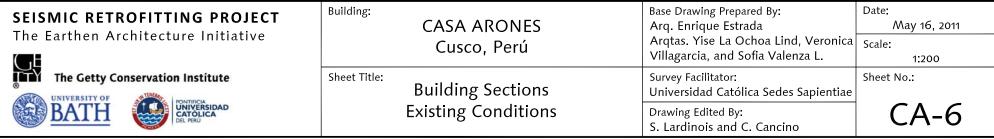


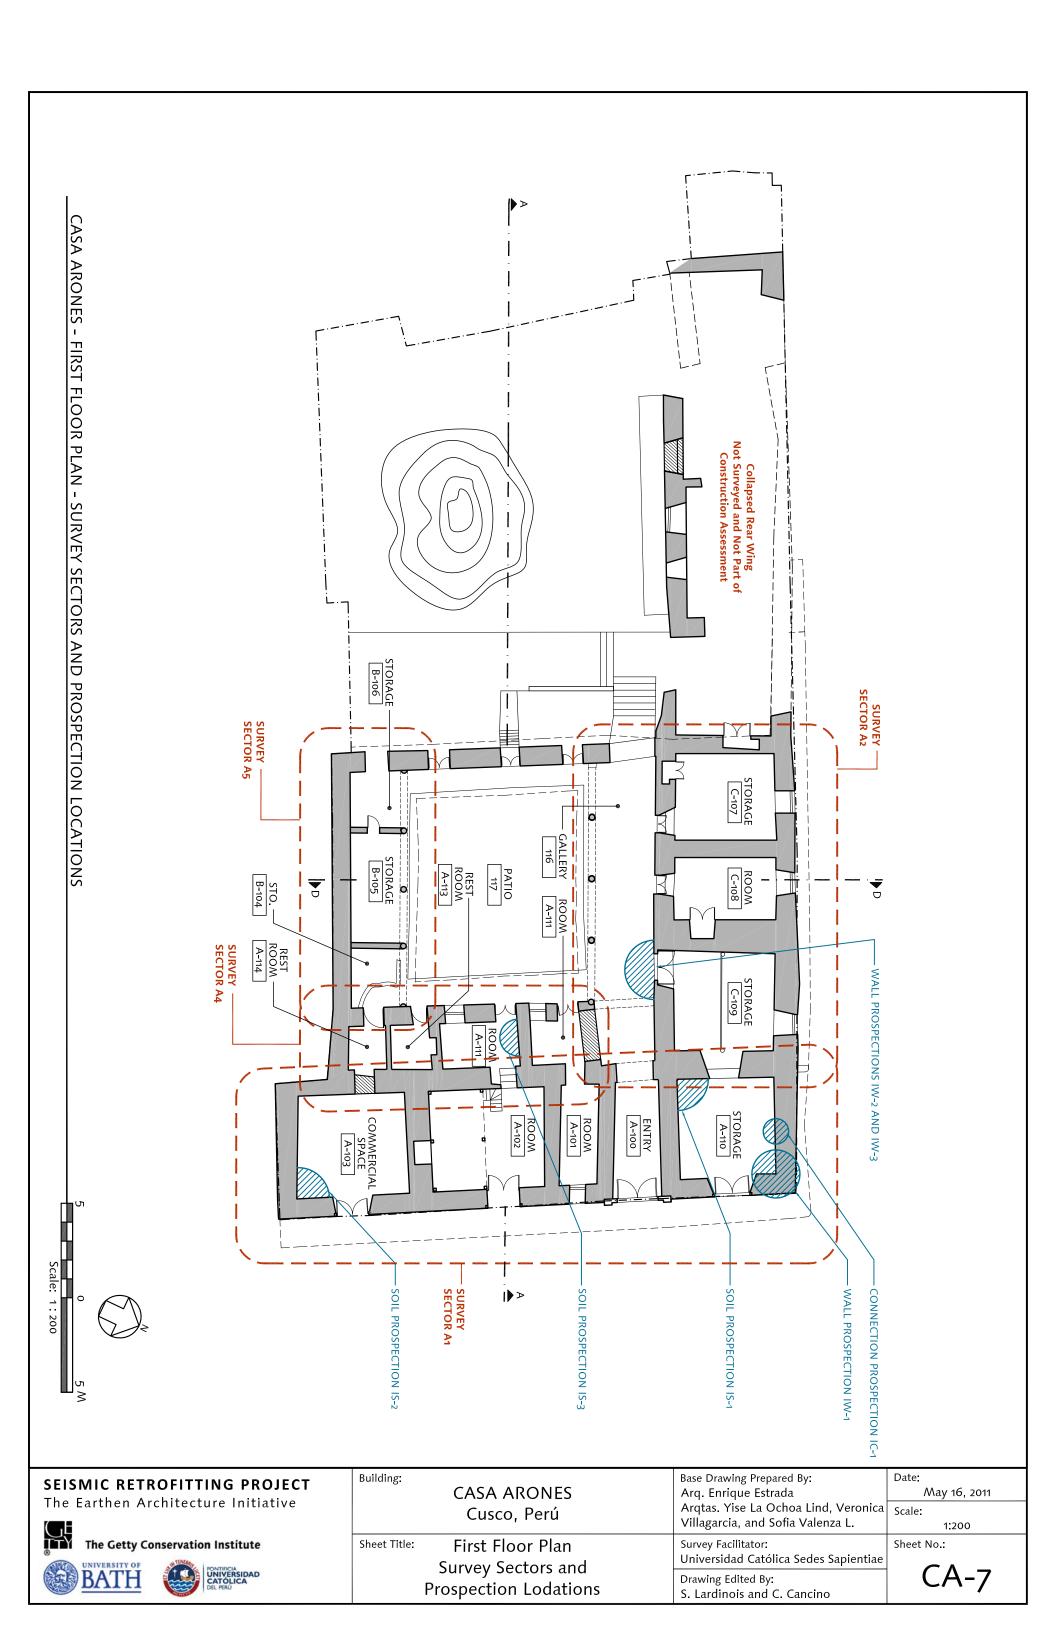

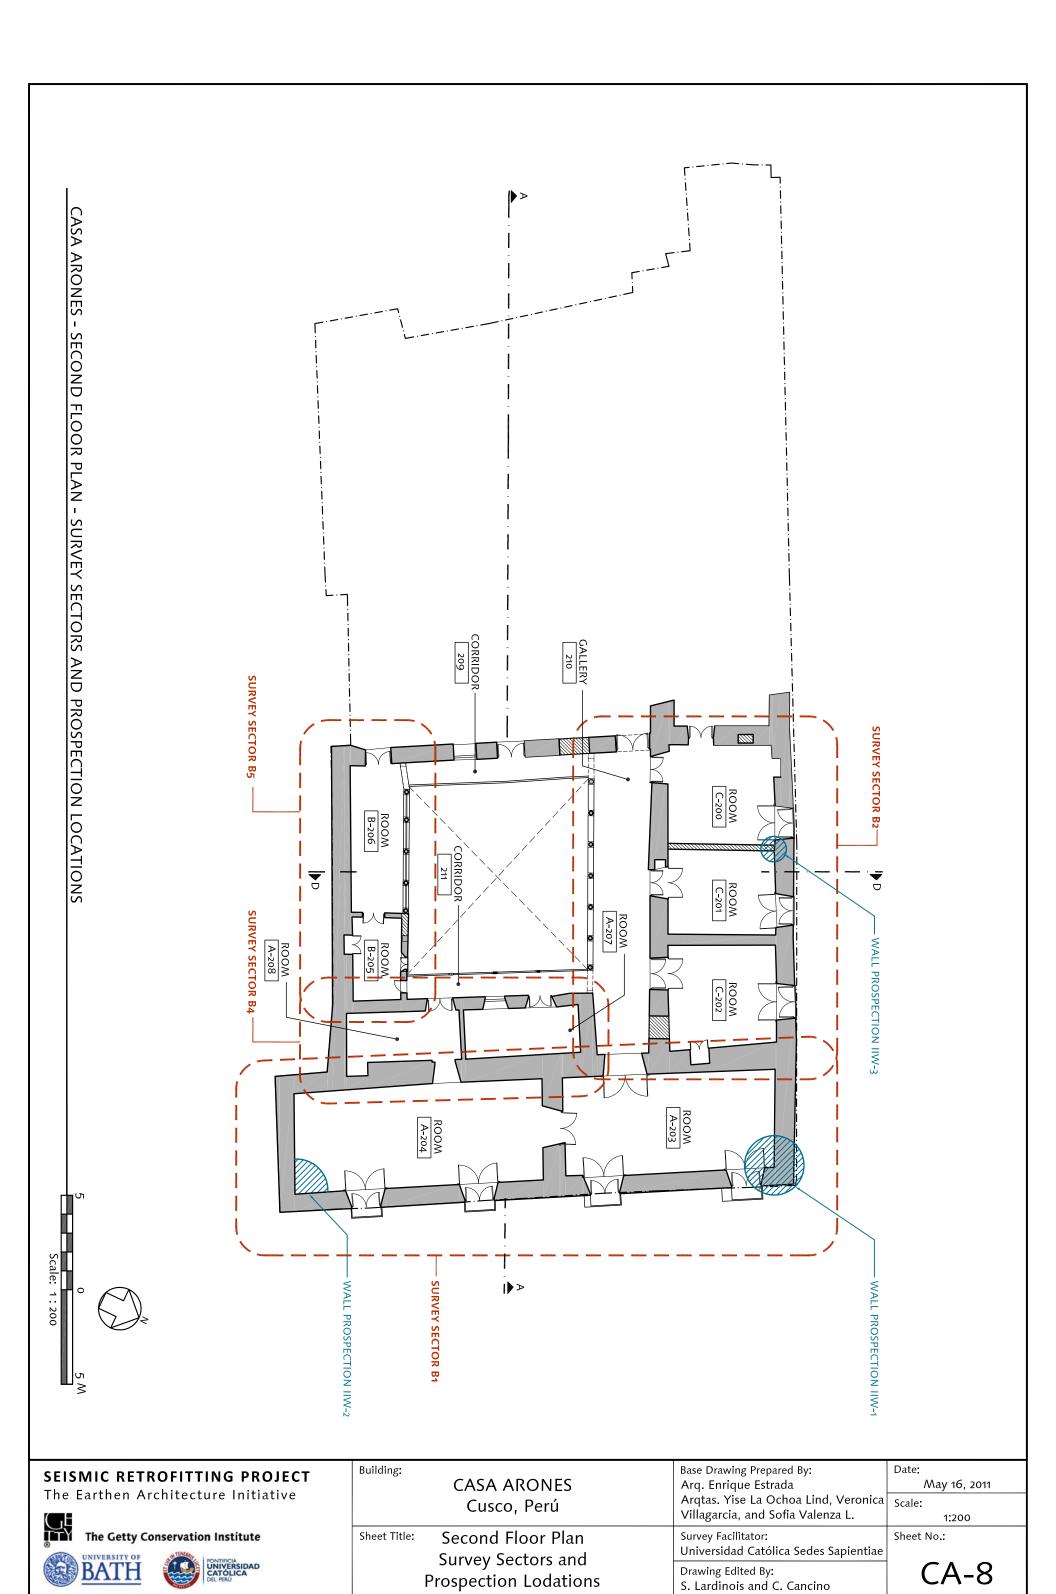

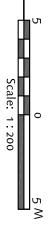

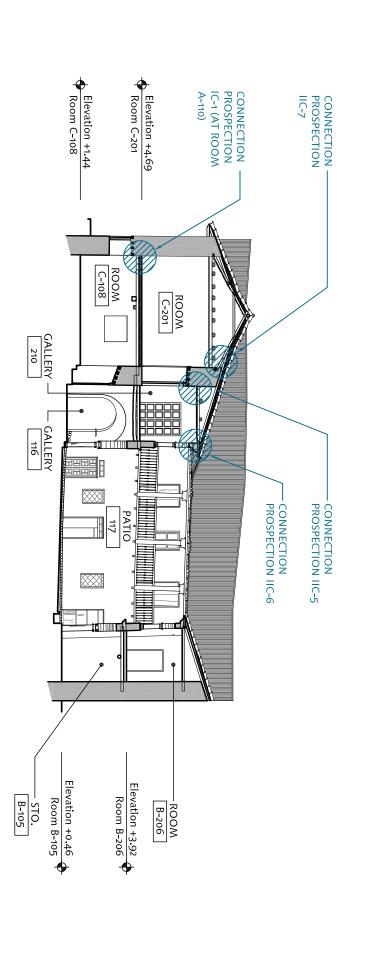

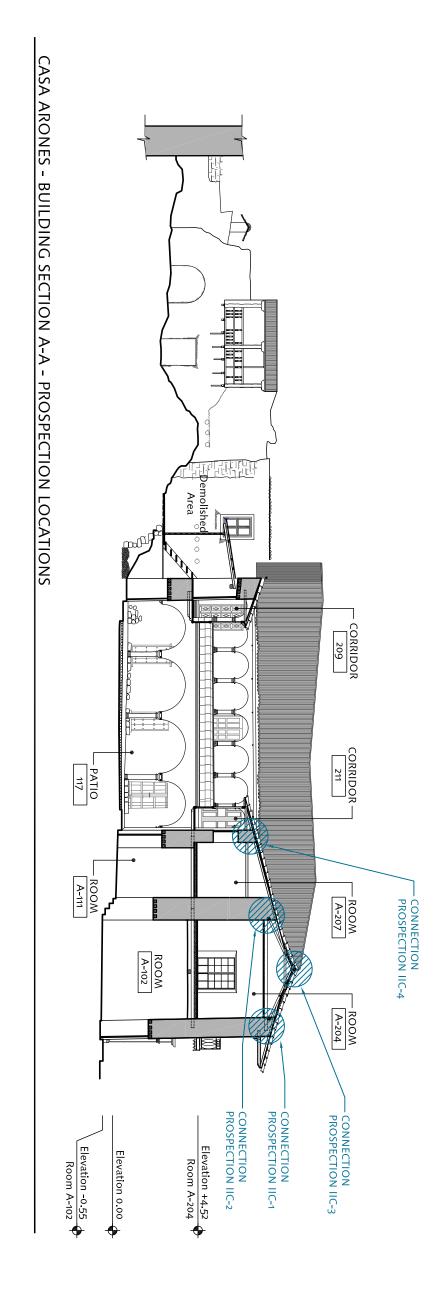



The Earthen Architecture Initiative





Building:

Sheet Title:

**CASA ARONES** Cusco, Perú

**Building Sections Prospection Locations**  Base Drawing Prepared By: Arq. Enrique Estrada Arqtas. Yise La Ochoa Lind, Veronica Scale: Villagarcia, and Sofia Valenza L.

S. Lardinois and C. Cancino

Drawing Edited By:

Universidad Católica Sedes Sapientiae

Survey Facilitator:

Date: May 16, 2011 1:200

Sheet No.:

CA-9